


T.8S. R.2W. W.M.

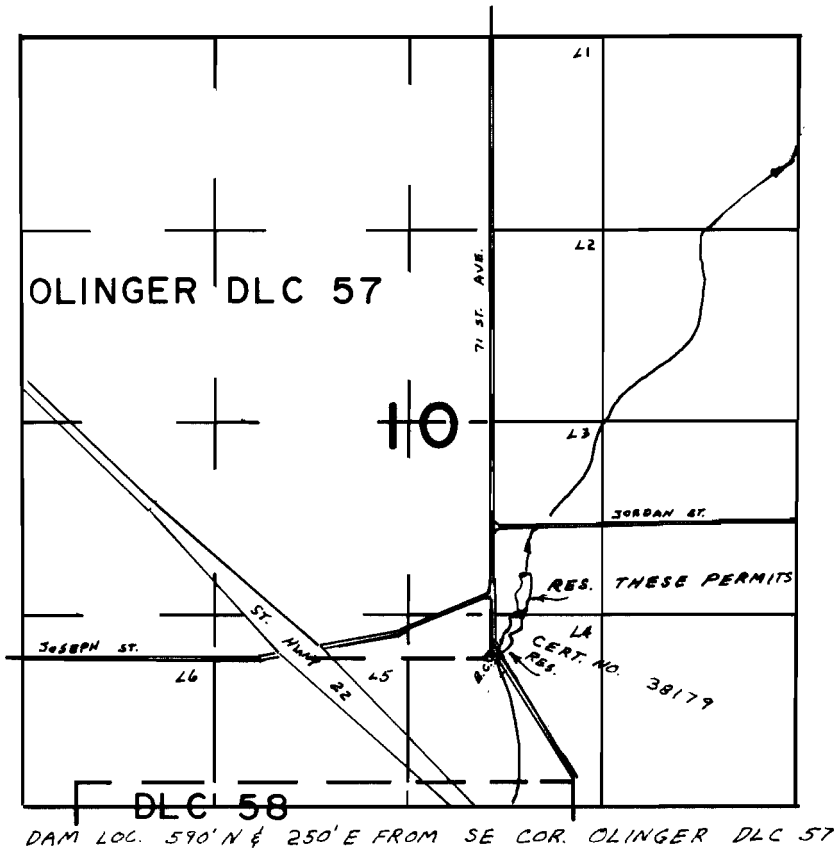

FINAL PROOF SURVEY UNDER

45450 33841
Application No. R-45449 Permit No. R-5353
IN NAME OF

GORDON D. WOODS

Surveyed JUL 1 1974, by L.H. NUNN