


T.4S.R.2W.W.M.

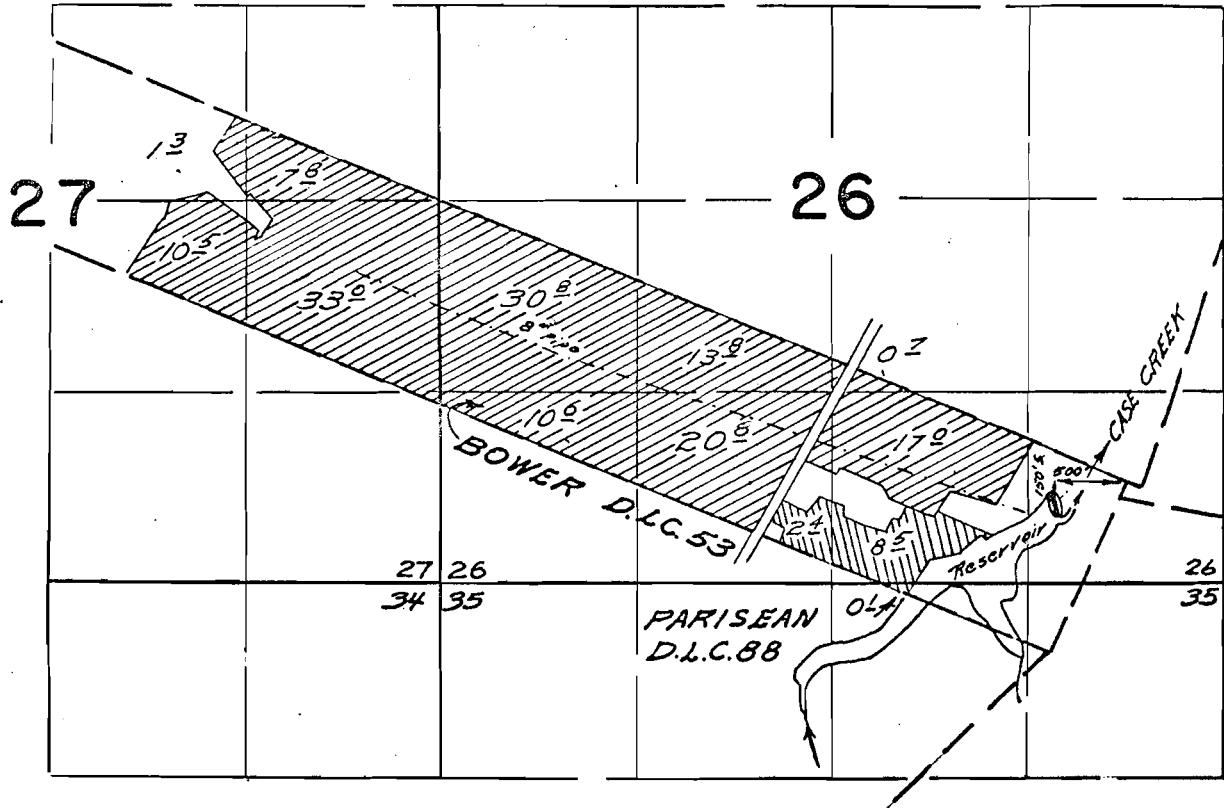

FINAL PROOF SURVEY

UNDER

R-48278

R-5669

48279

35333

~~R-43897~~

~~R-4943~~

Application No. ~~48117~~ Permit No. ~~32258~~

IN NAME OF

~~NEAL W. MILLER~~

HOBSON BROS.

Surveyed June 7, 1968 by W. J. Ruppert