


T.4S.R.2W.W.M.

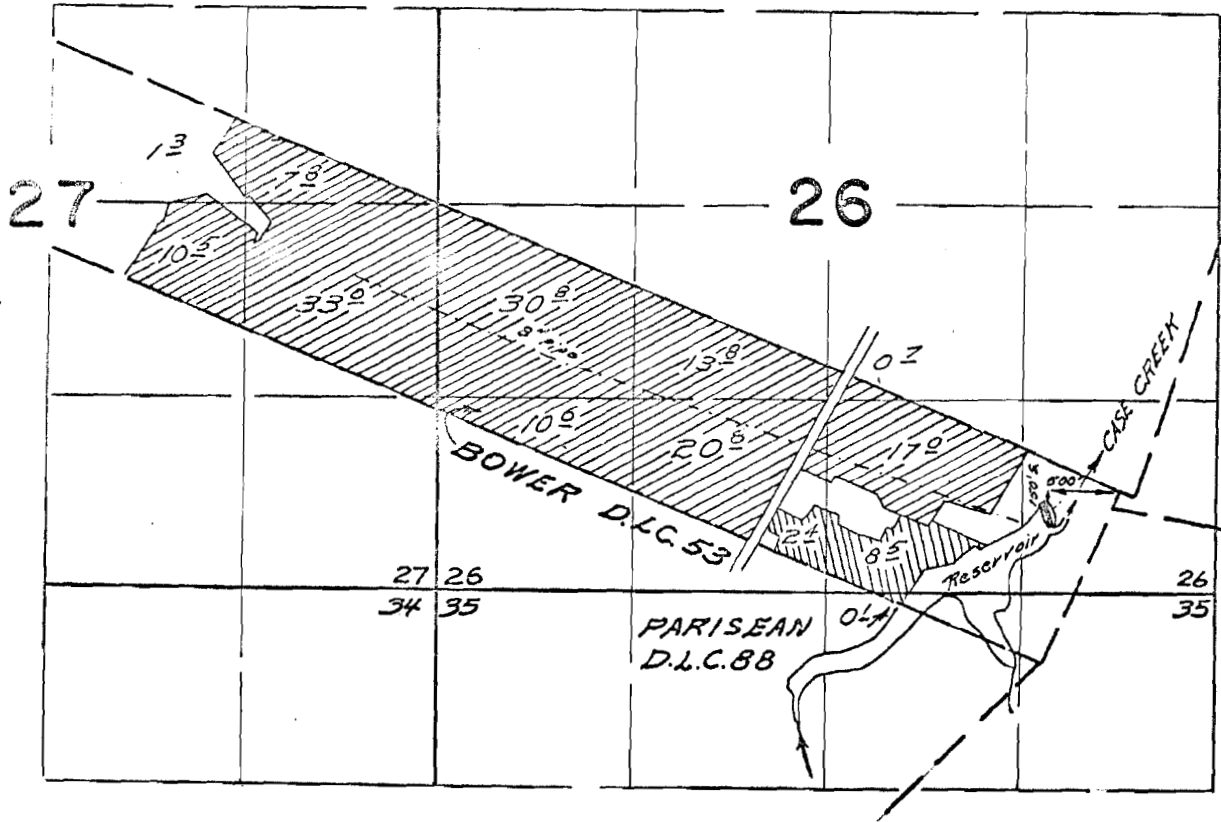

FINAL PROOF SURVEY

UNDER

L-43778

R-5667

49779

55333

R-43897

R-4943

Application No. 42113 Permit No. 32258

IN NAME OF

NEAL W. MILLER

HOBSON BROS.

Surveyed June 7, 1968 by W. J. Ruppelt.