


T.4S.R.IW.W.M.

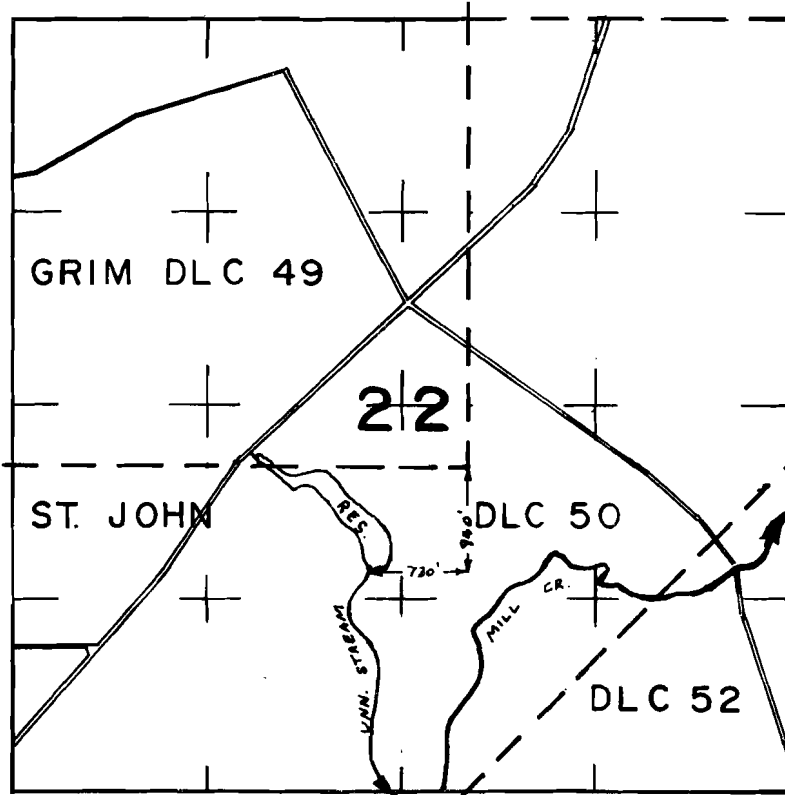

FINAL PROOF SURVEY

UNDER

R-51215

51216

R-48973

Application No. 48974

R-6229

38818

R-5839

Permit No. 36079

IN NAME OF

EVERT FREDERIKS

Surveyed MAY 21, 1974, by L.H. NUNN