


T.10S. R.6W. W.M.

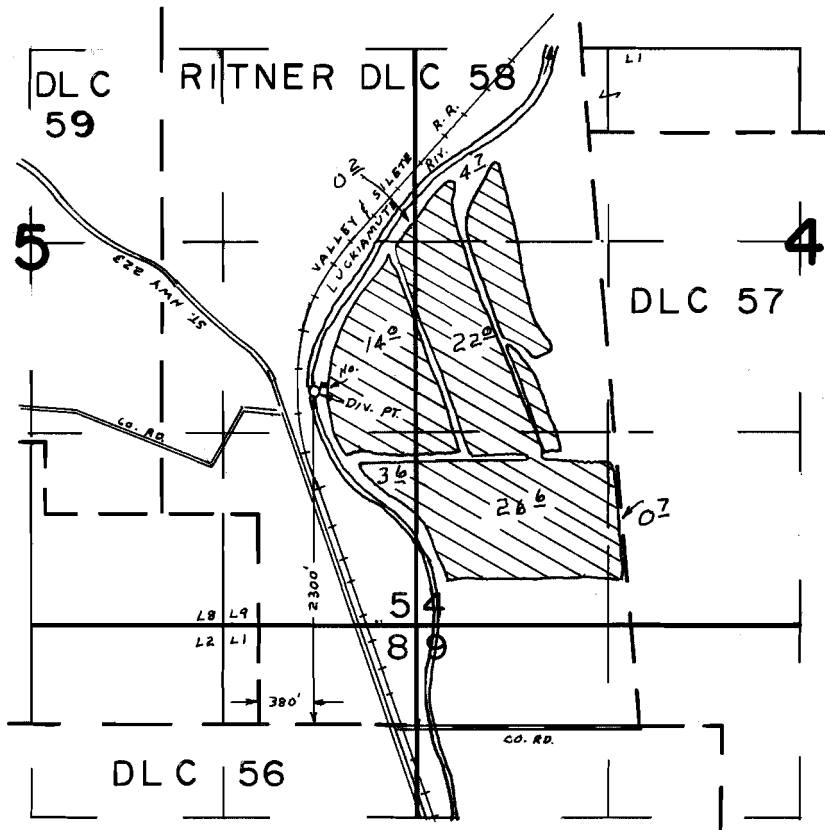

FINAL PROOF SURVEY UNDER

Application No. 44548. Permit No. 33345.
IN NAME OF

TOTO S. HALL

Surveyed JUL 16 1974, by LH NUNN