


T.6S. R.7W. W.M.

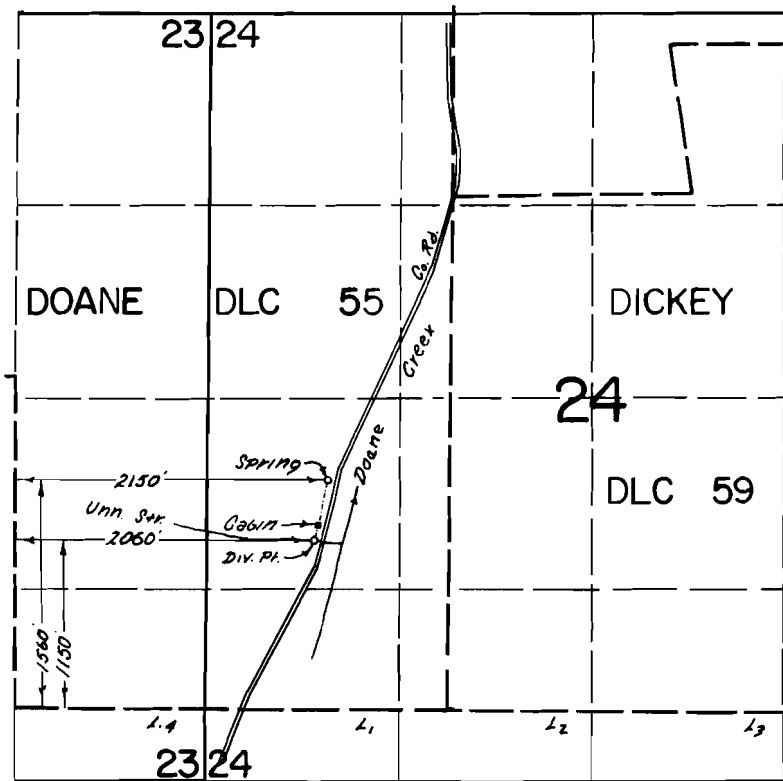

**FINAL PROOF SURVEY**  
UNDER

Application No. 46281.... Permit No. 34574....  
IN NAME OF

.....**MAE DEEN THOMAS**.....

Surveyed April 22 1974, by T. J. PAUL.....