


# T.8S. R.6W. W.M.

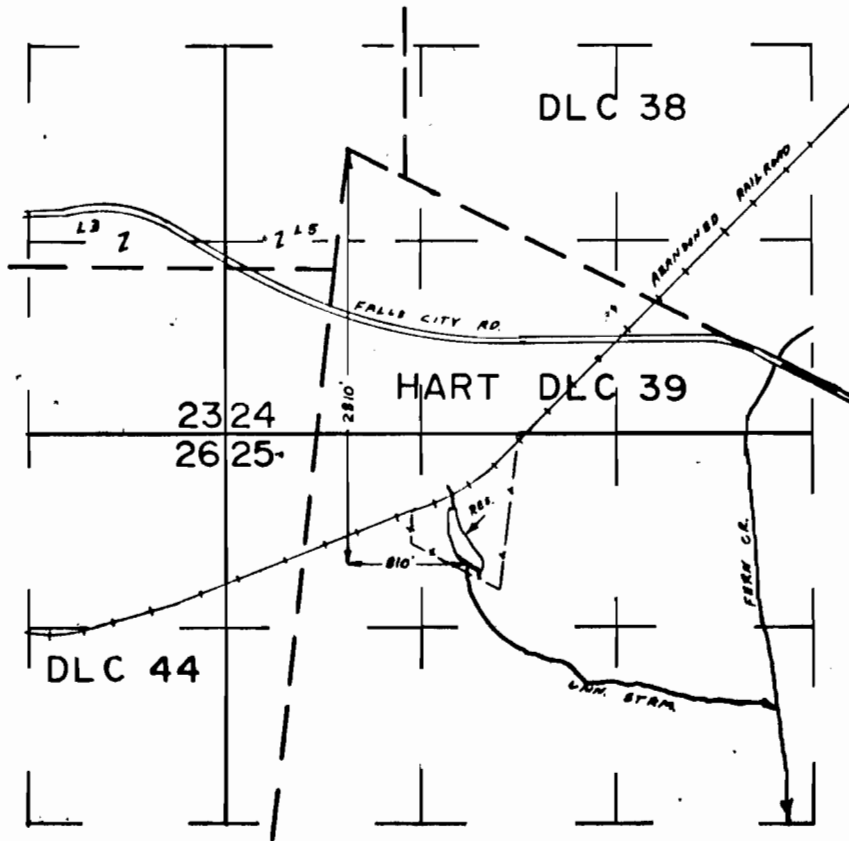

## FINAL PROOF SURVEY UNDER

R-47394                      R-5711  
Application No. 47395... Permit No. 35525...  
IN NAME OF

POND- A - BASS

Surveyed JUL 16 1974, by L.H. NUNN