


T. 36S. R. 11E. W. M.

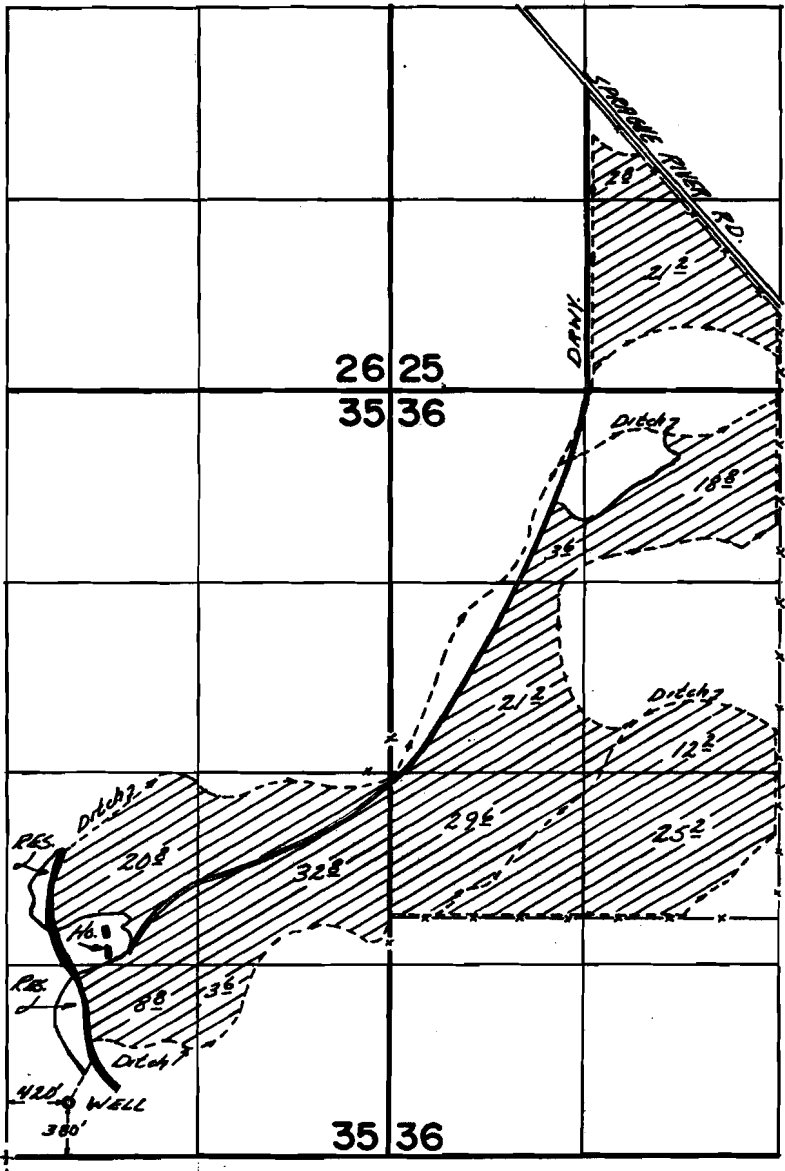

whiskey cke. wells

FINAL PROOF SURVEY UNDER

Application No. G-5564 Permit No. G-5810...
IN NAME OF

.....WILLIAM V. HILL.....

Surveyed Sept. 21 1979, by C.R. RODRIGUEZ