


T. 6 N. R. 34 E. W. M.

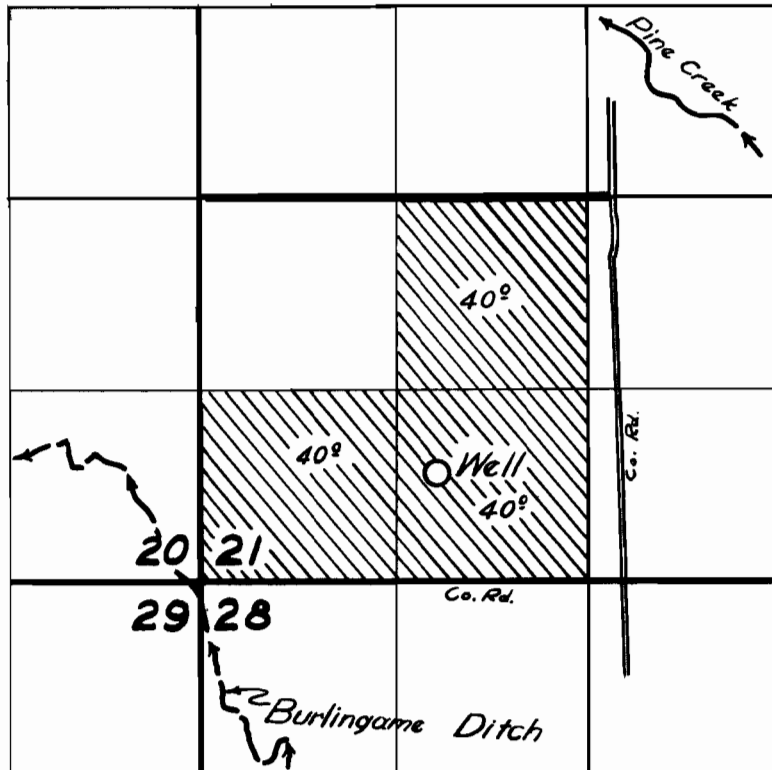

**FINAL PROOF SURVEY**

UNDER

Application No. U-484 Permit No. U-452

IN NAME OF

H. S. MURRAY

Surveyed 5 Nov. 1955, by [Signature]

NZ-5F-111