


G-4935
47977

T.4N. R.29E. W.M.

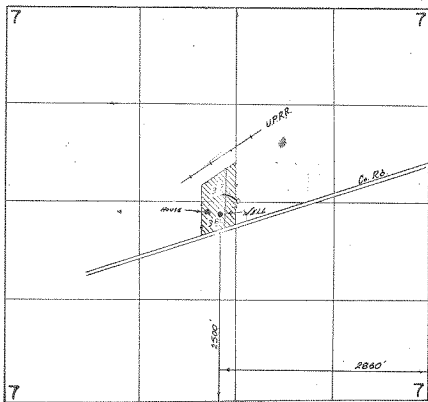

FINAL PROOF SURVEY
UNDER

Application No. ^{G-4935} G-5603 Permit No. G-5603
IN NAME OF

JOHN M. & EDITH WESTON

Surveyed APRIL 16, 1978, by THOMAS J. PAUL