


T.2S. R.45E. W.M.

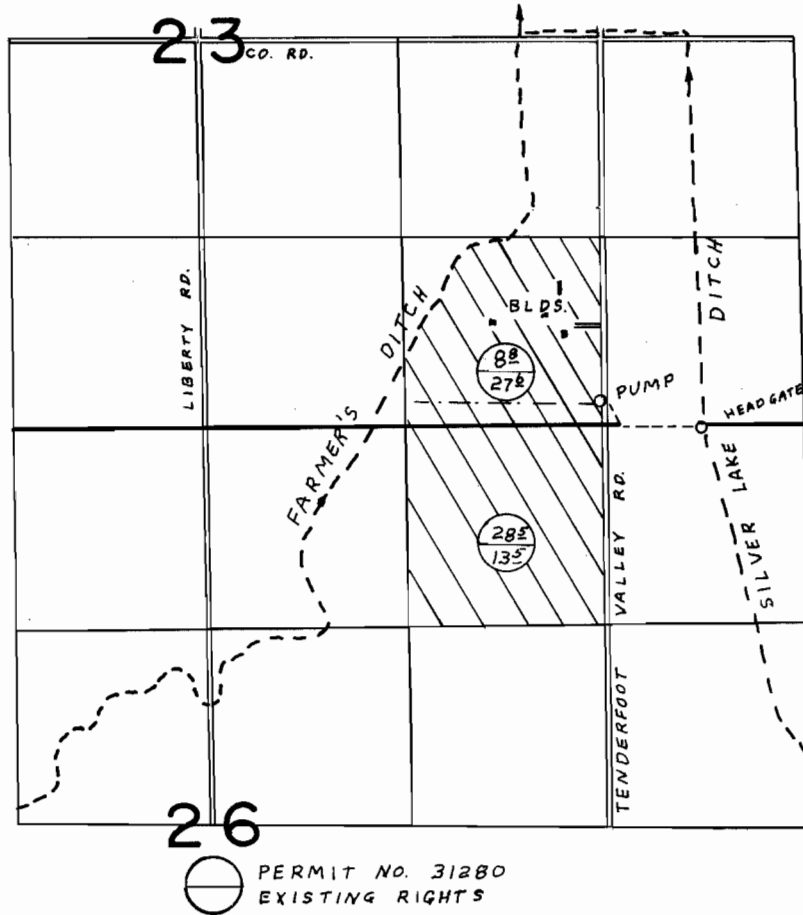

FINAL PROOF SURVEY UNDER

Application No. 41741 Permit No. 31280
IN NAME OF

JAMES D. TIPPETT

Surveyed AUG 4 1973, by R. MUCKEN