


T.3S. R.4W. W.M.

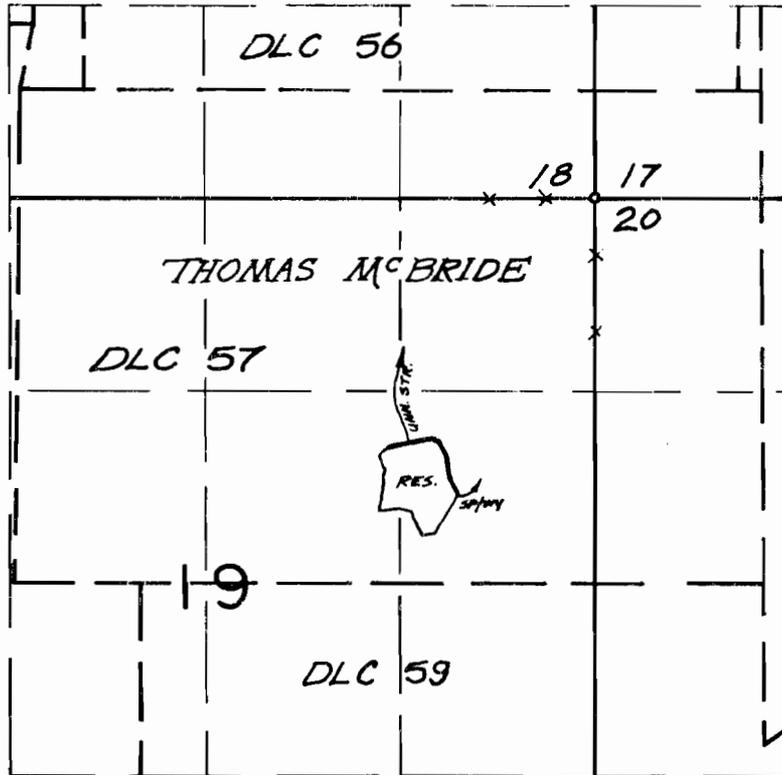

DAM LOCATED 1660' S., 1260' W., FROM N.E. CORNER SECTION 19

FINAL PROOF SURVEY
UNDER

R 47127 R 5592
Application No. 47128 Permit No. 34938
IN NAME OF

OBERG BROTHERS

Surveyed JUNE 13 1974, by L.M. TOLL