


T.3 S. R.5 W. W.M.

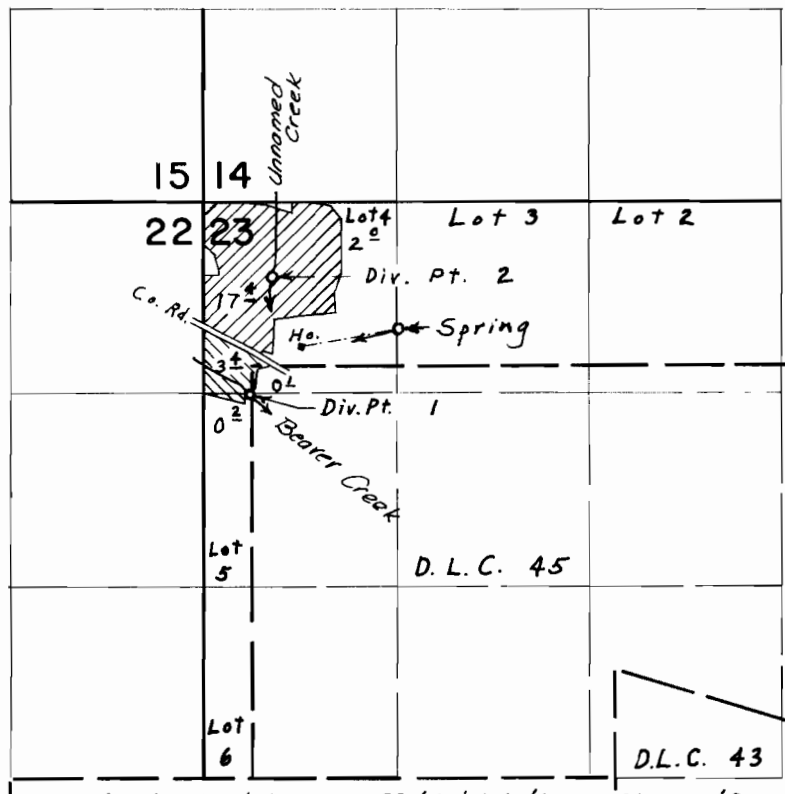


Div. Pts. located: Spring, 880' S. & 1340' E., Unn. Str., 530' S.
& 480' E., Beaver Cr., 1330' S. & 320' E., all from N.W. Cor. Sec. 23

From Div. Pt. 1



From Div. Pt. 2

 

FINAL PROOF SURVEY UNDER

Application No. 47430 Permit No. 35538
IN NAME OF

GEORGE M. HAMPTON

Surveyed May 30 1974, by L. E. Gould