
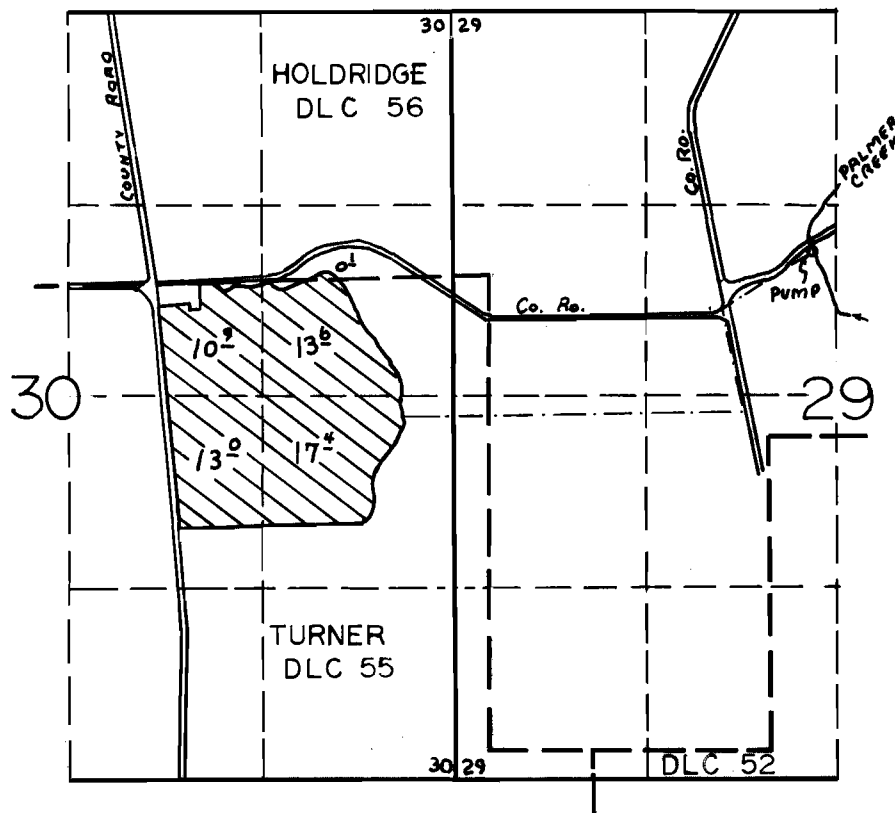


T.6S., R.3W., W.M.

T.4S., R.3W., W.M.

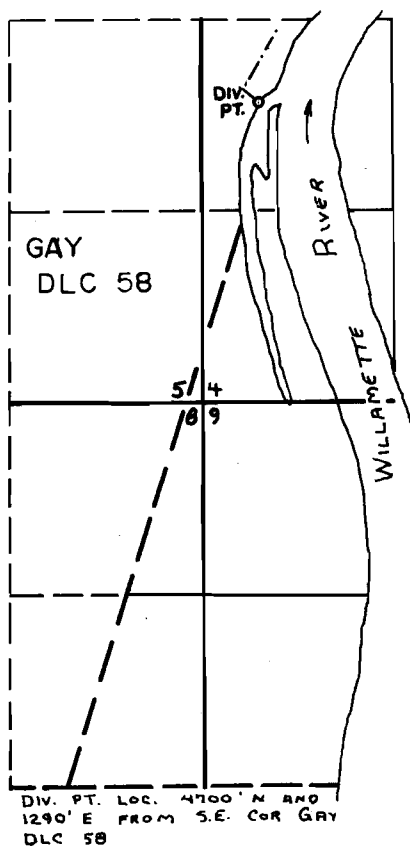

**FINAL PROOF SURVEY**  
UNDER

Application No. 48224 Permit No. 36216..  
IN NAME OF  
PALMER CREEK WATER DISTRICT  
IMPROVEMENT COMPANY

Surveyed JUNE 12 1974, by L. Toll