


T.13S., R.6W., W.M.

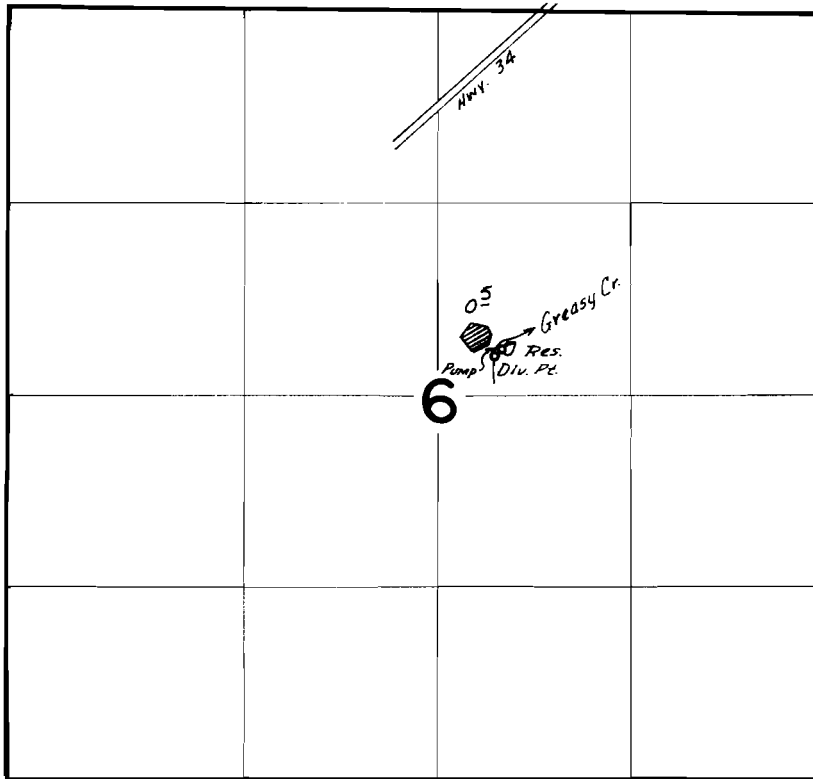

DIV. PT. LOC.: CR. - 2370'S & 390'E; RES. - 2280'S & 470'E BOTH FROM N 1/4 COR. SEC. 6.

**FINAL PROOF SURVEY**  
UNDER

R-50764                      R-5972  
Application No. 50765      Permit No. 36801  
IN NAME OF

MILTON E. ROWLAND

Surveyed Aug. 15 1975, by D. Norby