


T.4S., R.2E., W.M.

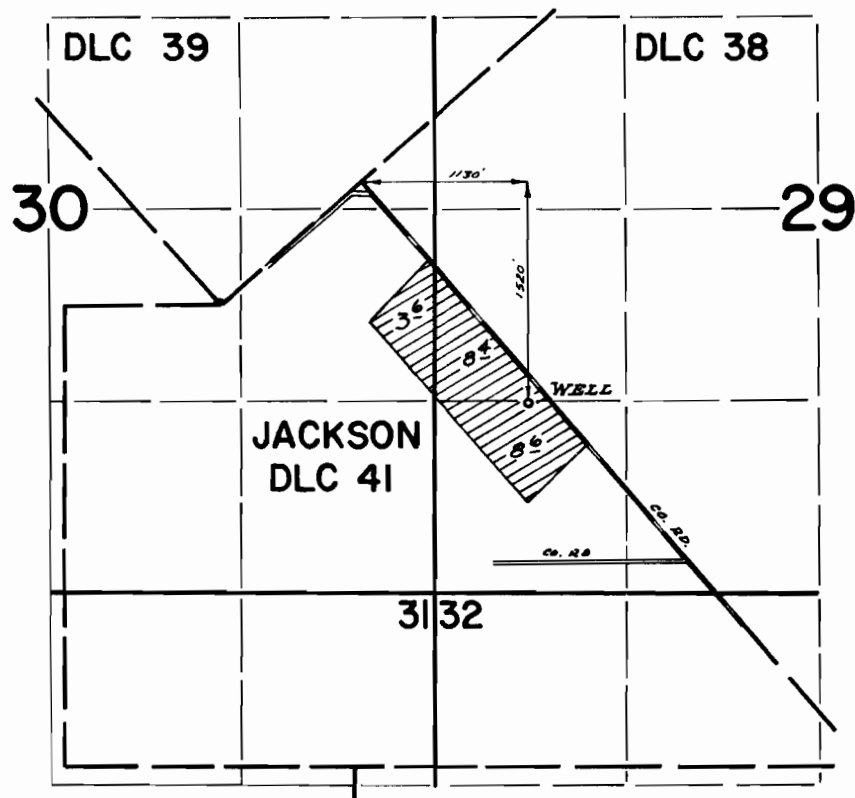

**FINAL PROOF SURVEY**  
UNDER

Application No. G-3863 Permit No. G-3637  
IN NAME OF

BRUNO O. KRAXBERGER

Surveyed Sept. 3 1974, by D. D. Doby