


T.4S., R.2E., W.M.

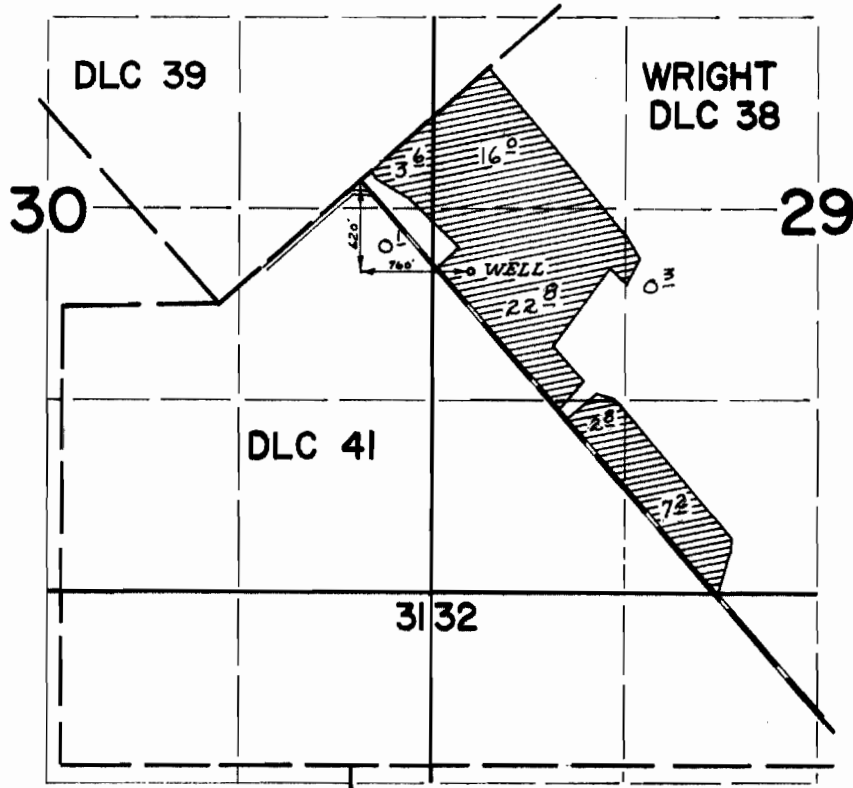

FINAL PROOF SURVEY
UNDER

Application No. G-5001 Permit No. G-4719
IN NAME OF

V. H. STEINHAUSER

Surveyed Sept. 3 1974, by D. Dorby