


# T. 5 S. R. 1 E. W. M.

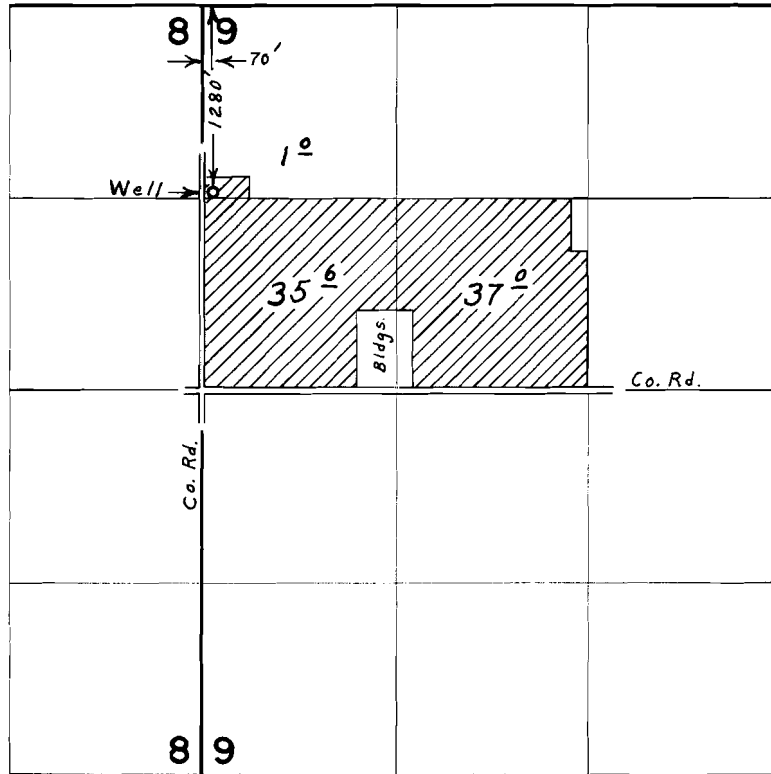

## FINAL PROOF SURVEY UNDER

Application No. G-5219 Permit No. G-5080  
IN NAME OF

BILL L. ROSE

Surveyed June 20, 1974, by L. E. Gould