


T.2S. R.4E. W.M.

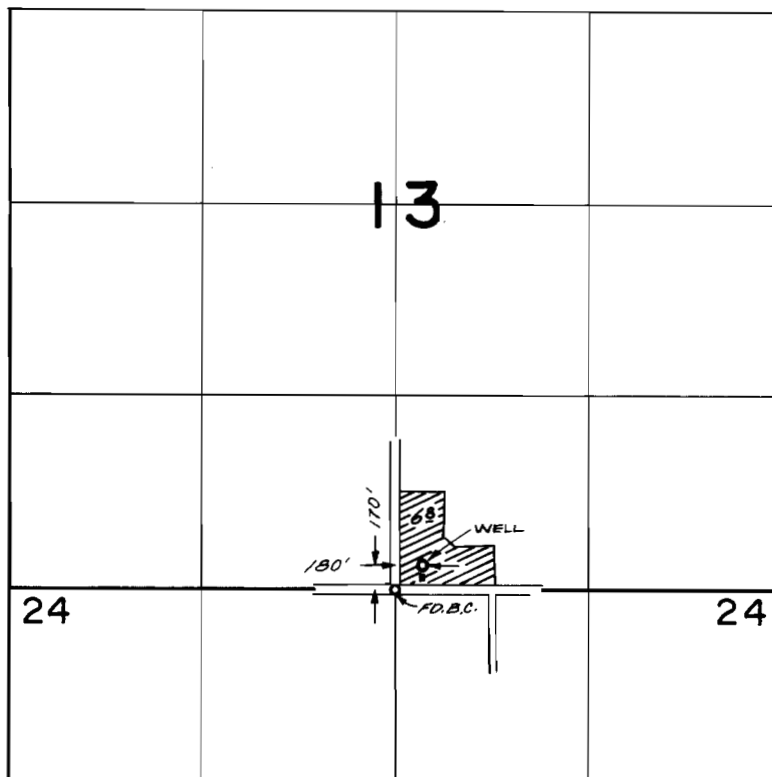

FINAL PROOF SURVEY
UNDER

Application No. G.5311 Permit No. G.5137
IN NAME OF

JOHN E. & ARLETHA E. MILLS

Surveyed SEPT. 26 1975, by R.G. MUCKEN