


T.5 S. R.1 E. W.M.

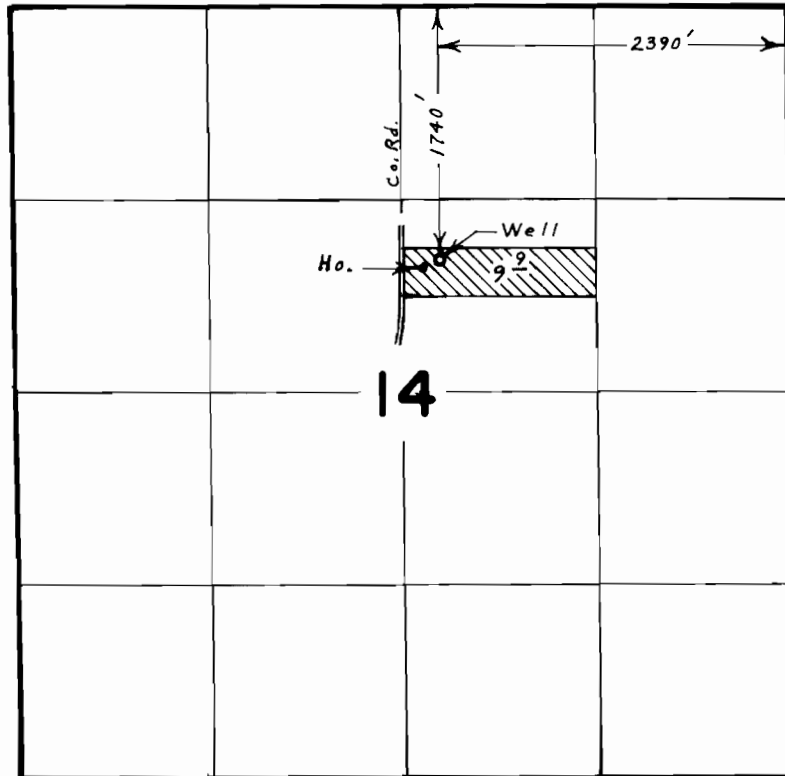

FINAL PROOF SURVEY
UNDER

Application No. G-5904 Permit No. G-5259
IN NAME OF

ALVA R. BLUNK

Surveyed Sept. 29 1975, by L. E. Gould