


T.3 S. R.4 E. W.M.

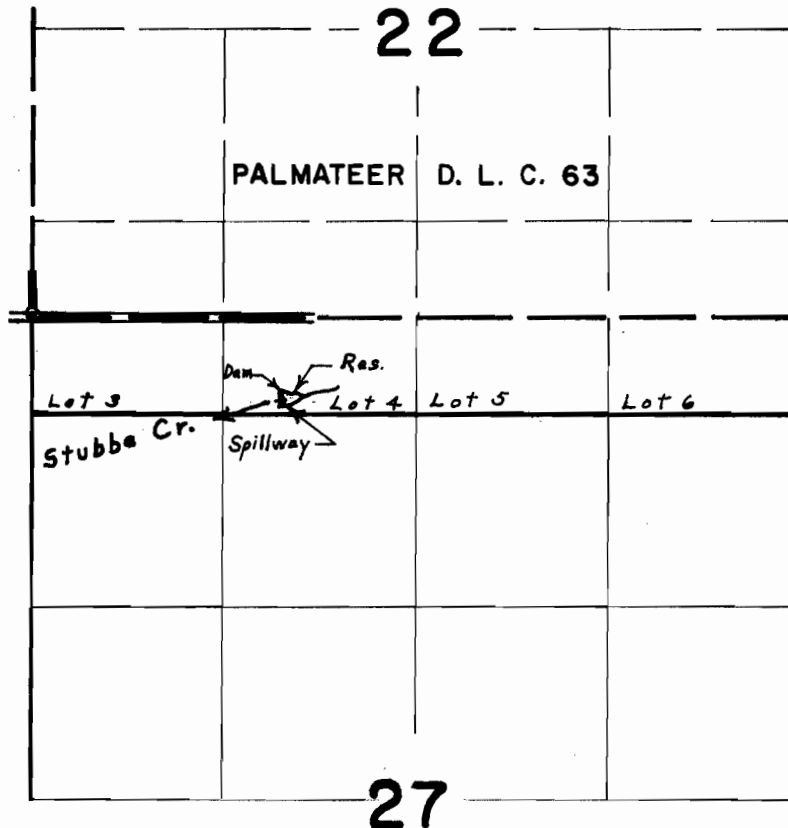

FINAL PROOF SURVEY

UNDER

Application No. ~~R-48842~~ Permit No. R-5816

IN NAME OF

THEODORE A. SCHIMPF

Surveyed Aug. 27, 1975, by L. E. Gould