


T.3 S. R.4 E. W.M.

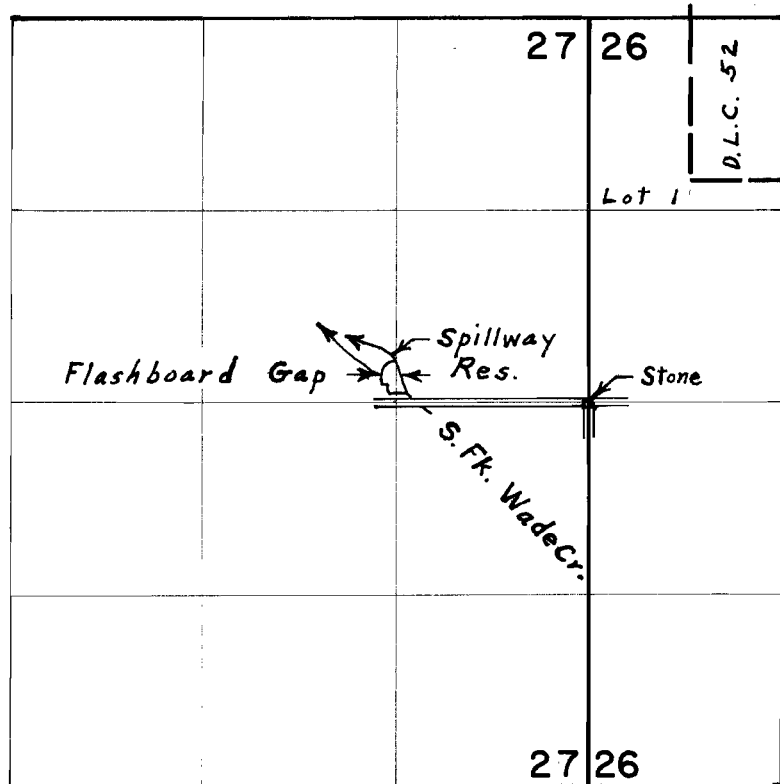

FINAL PROOF SURVEY

UNDER

Application No. R-49211 Permit No. R-5818

IN NAME OF

LARRY A. DONALDSON

Surveyed Aug. 27, 1975, by L. E. Gould