


T.4S., R.2E., W.M.

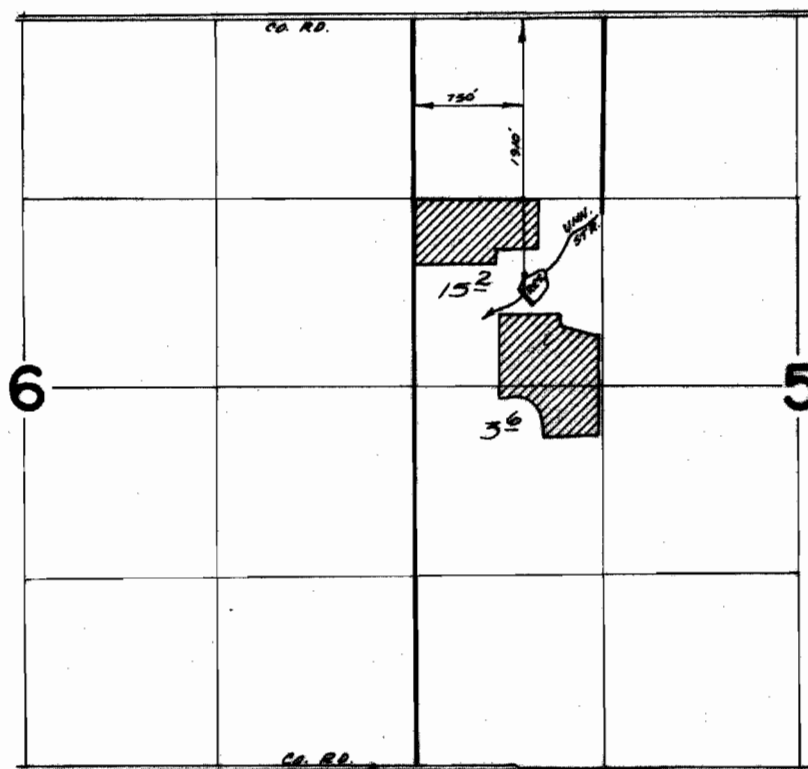

FINAL PROOF SURVEY
UNDER

R-42416

R-4715

Application No. 42417 Permit No. 31206
IN NAME OF

CHARLES STRICKER

Surveyed Sept. 5 1974, by S. Dorby