


T.2S. R.3E. W.M.

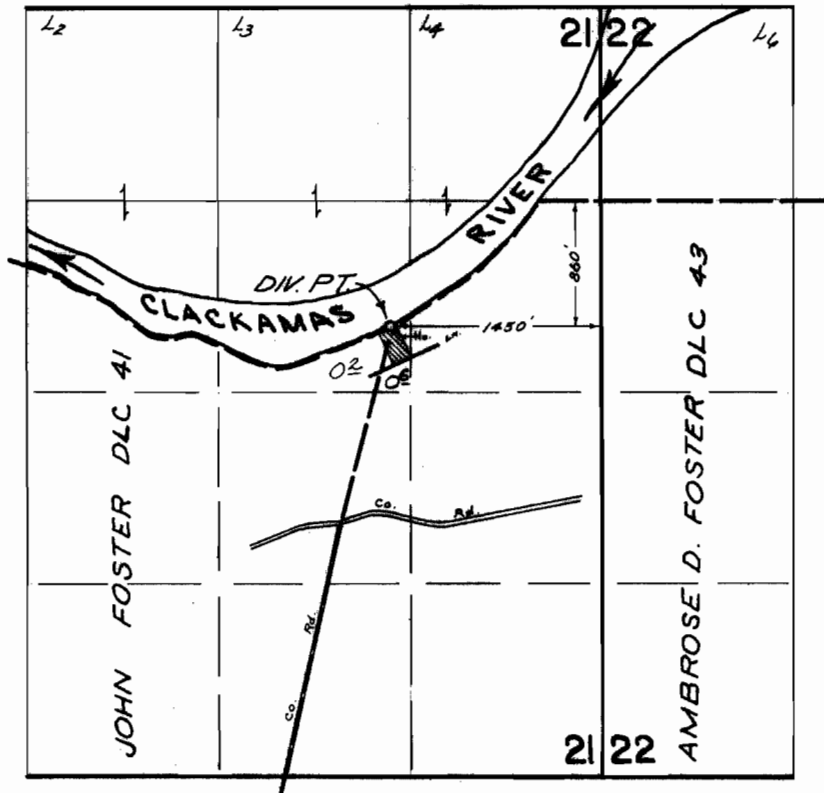

FINAL PROOF SURVEY
UNDER

Application No. 43847 Permit No. 32770
IN NAME OF

ROBERT C. NAEF

Surveyed OCT. 3, 1974, by L.E. GOULD