


T. 2S. R. 5E. W.M.

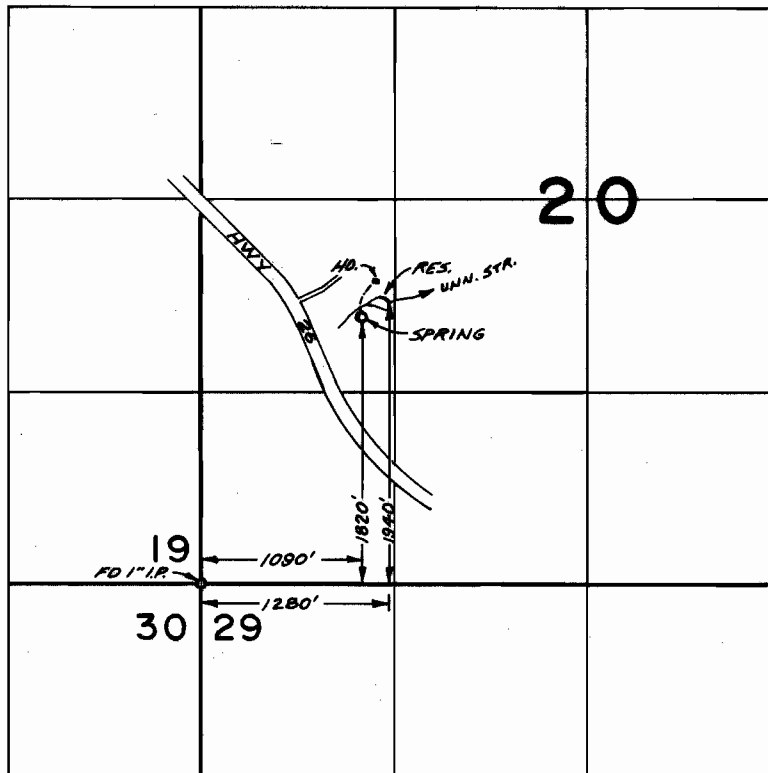

**FINAL PROOF SURVEY**  
UNDER

Application No. 47016 R 47015 Permit No. 34792 R 5554  
IN NAME OF

MIKE MAHAFFEY

Surveyed SEPT. 24 1975, by R. G. MUCKEN