


T. 2S. R. 5E. W.M.

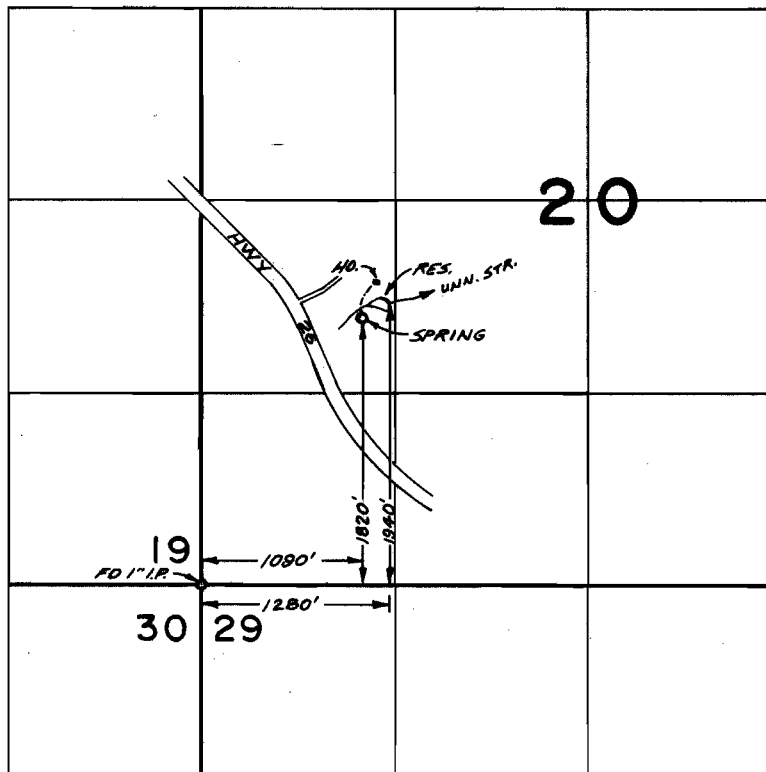

FINAL PROOF SURVEY
UNDER

47016 34792
Application No. R 47015 Permit No. R 5554
IN NAME OF
MIKE MAHAFFEY

Surveyed SEPT. 24 1975, by R. G. MUCKEN