


T. 5 S. R. 3 E. W.M.

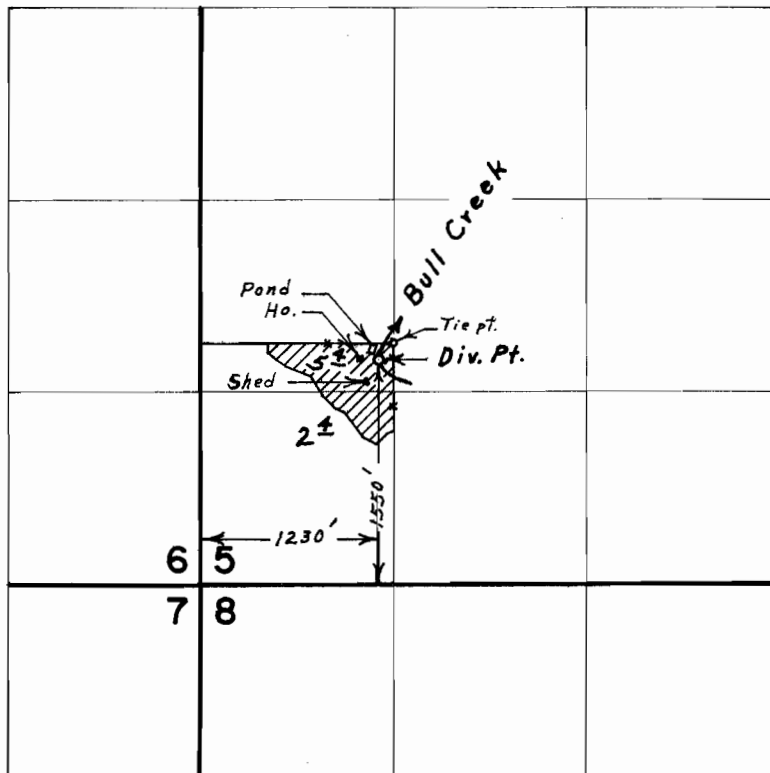

FINAL PROOF SURVEY

UNDER

Application No. 47071 Permit No. 35204

IN NAME OF
TREVOR R. HUMPHREYS

Surveyed May 29, 1975, by L. E. Gould