


T. 6 S. R. 2 E. W.M.

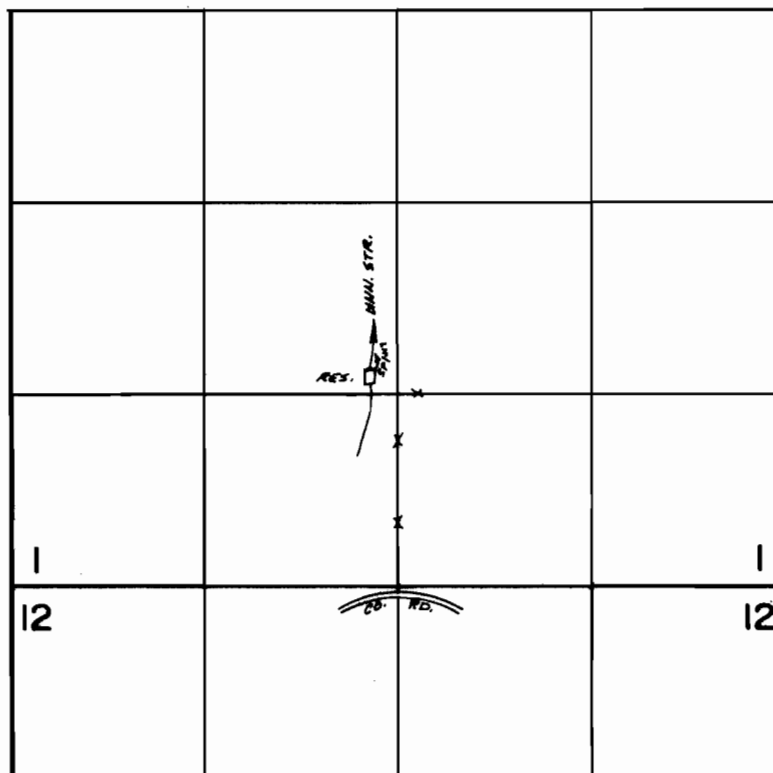

DIV. PT. 180' N., 180' W. FROM SE. COR. OF N.E. 1/4 OF SW. 1/4

FINAL PROOF SURVEY
UNDER

48580 35340
Application No. R 48579 Permit No. R 5673
IN NAME OF

ERNEST ZAHAR

Surveyed SEPT. 4 1975, by R.G. MUCKEN