


# T. 2 S. R. 1 E. W. M.

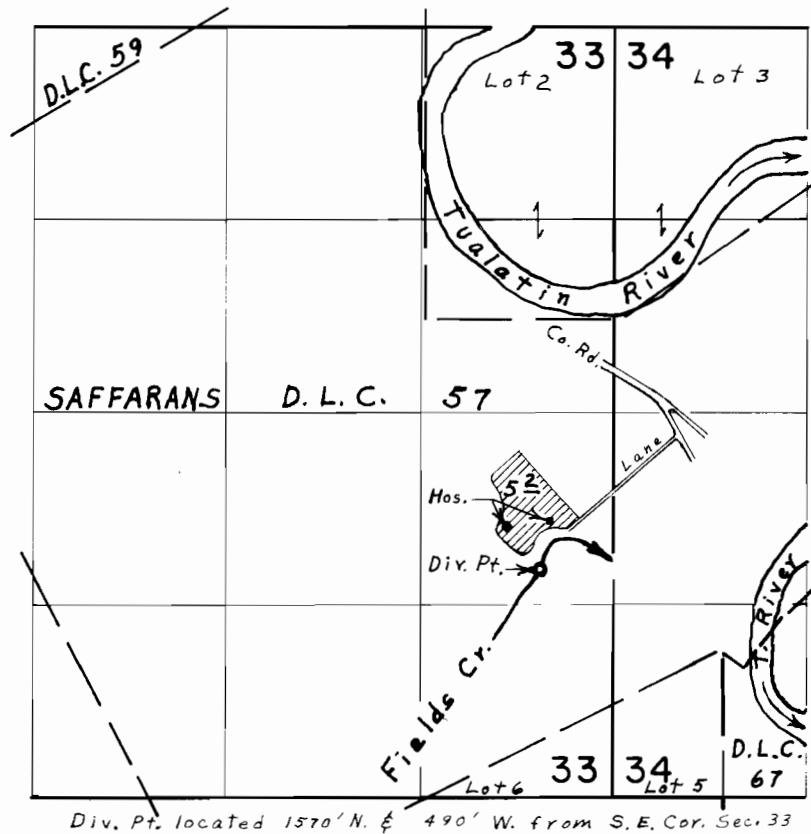

## FINAL PROOF SURVEY UNDER

Application No. 47198... Permit No. 35356  
IN NAME OF

STANLEY G. JEWETT, JR.

Surveyed Sept. 30, 1975, by L. E. Gould