


# T. 3 & 4 S. R. 1 E. W. M.

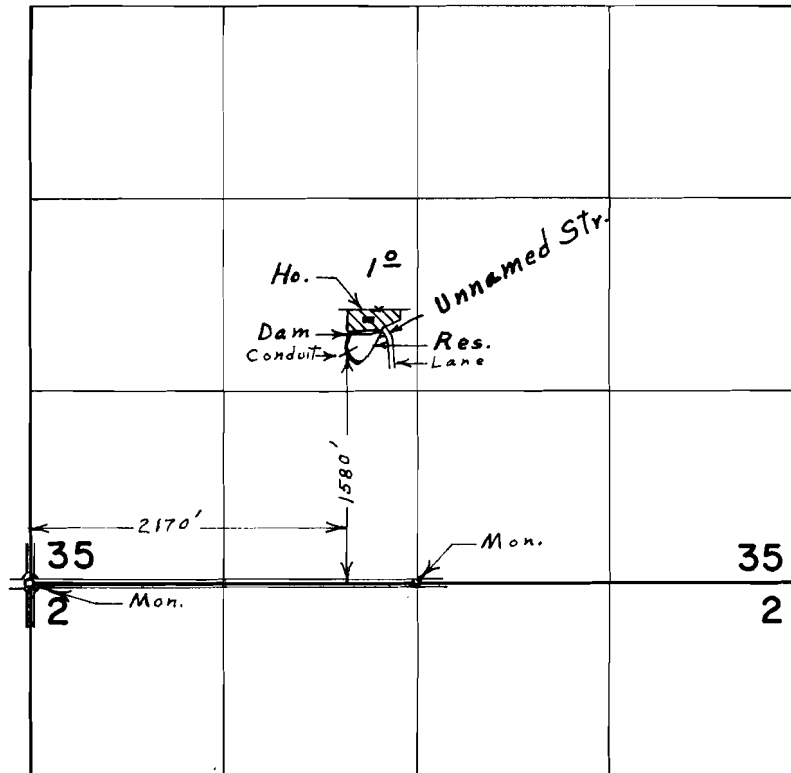

## FINAL PROOF SURVEY

UNDER

R-47953 R-5687  
 Application No. 47954 Permit No. 35408

IN NAME OF

ADOLPH CEREGHINO

Surveyed May 6, 1975, by L. E. Gould