


T.2S. R.4E. W.M.

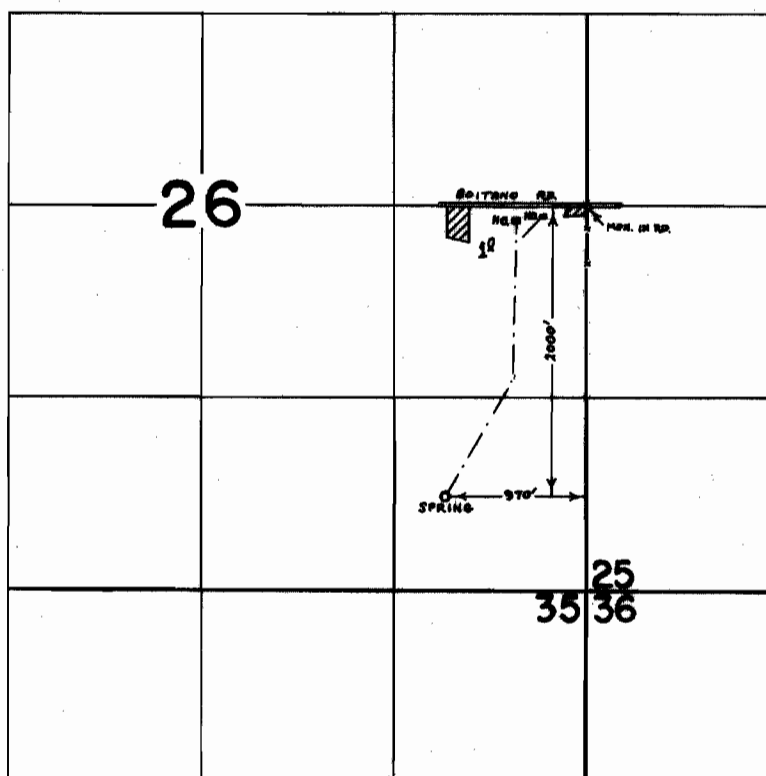

FINAL PROOF SURVEY
UNDER

Application No. 47510 Permit No. 35482
IN NAME OF

GERALD R. GRASSL

Surveyed OCT. 24 1975, by L. TOLL