


T.2S.R.4E. W.M.

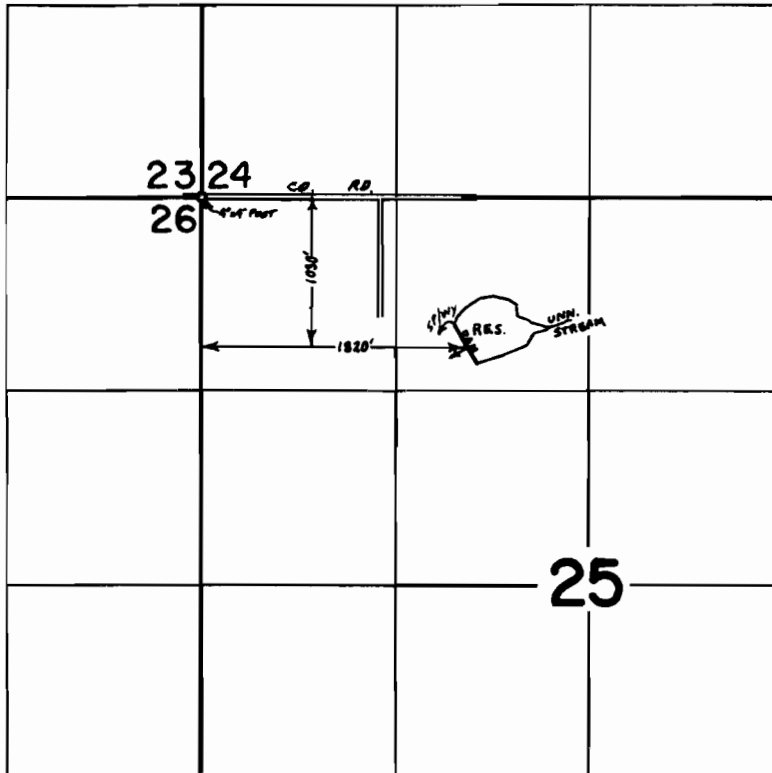

FINAL PROOF SURVEY

UNDER

Application No. **R-49132** Permit No. **R-5808**
49133 **35930**
 IN NAME OF

NORMAN O. ISAKSON

Surveyed OCT. 20 1975, by L. TOLL