


T.4S. R.4E. W.M.

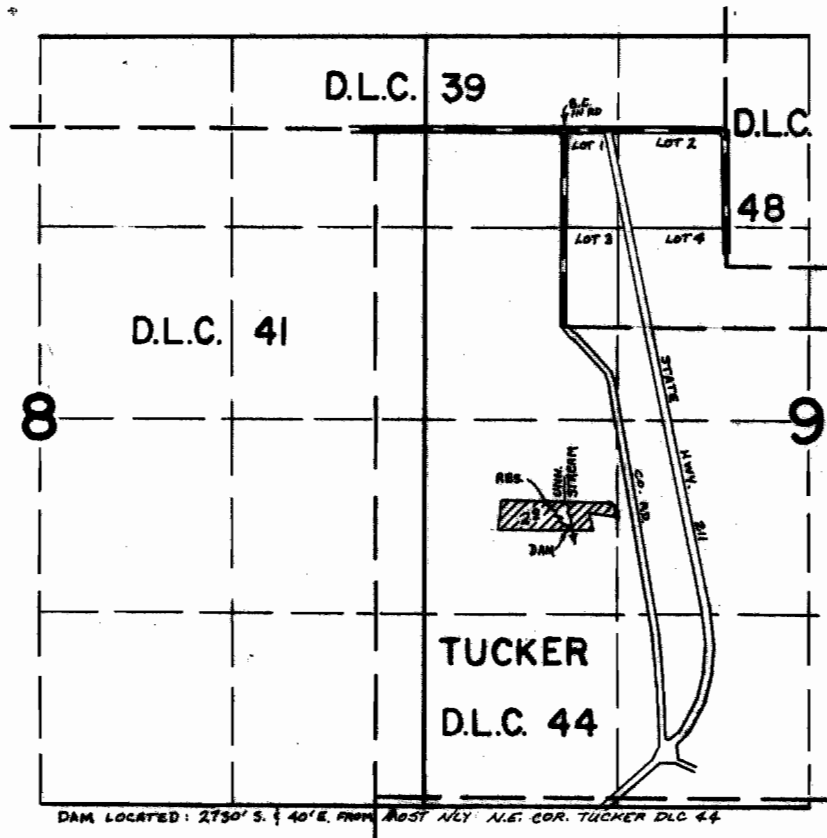

FINAL PROOF SURVEY
UNDER

R-48175 R-5812
Application No. 48176 Permit No. 35959
IN NAME OF

O. K. WEBBER

Surveyed OCT. 23 1975, by L. TOLL