


T.3 S. R.2 E. W.M.

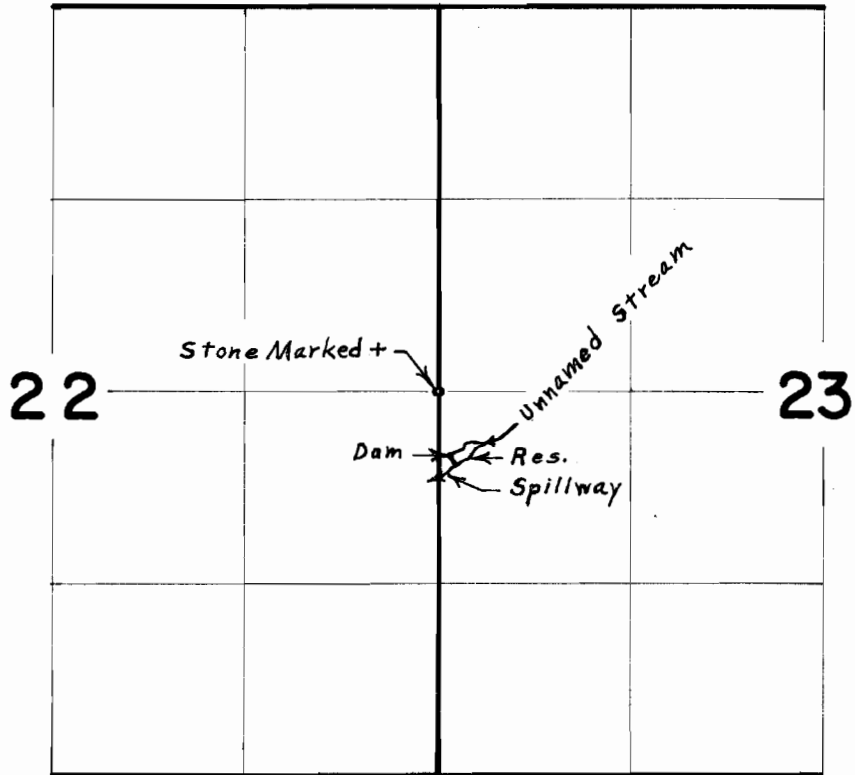

DIV. PT. 500'S. & 100'E. FROM W. 1/4 COR. SEC. 23

FINAL PROOF SURVEY

UNDER

Application No. ~~48476~~ <sup>R-48475</sup> Permit No. ~~36381~~ <sup>R-5887</sup>

IN NAME OF

RICHARD K. KIRBY

Surveyed May 7, 1975, by L. E. Gould