


T.3 S. R.2 E. W.M.

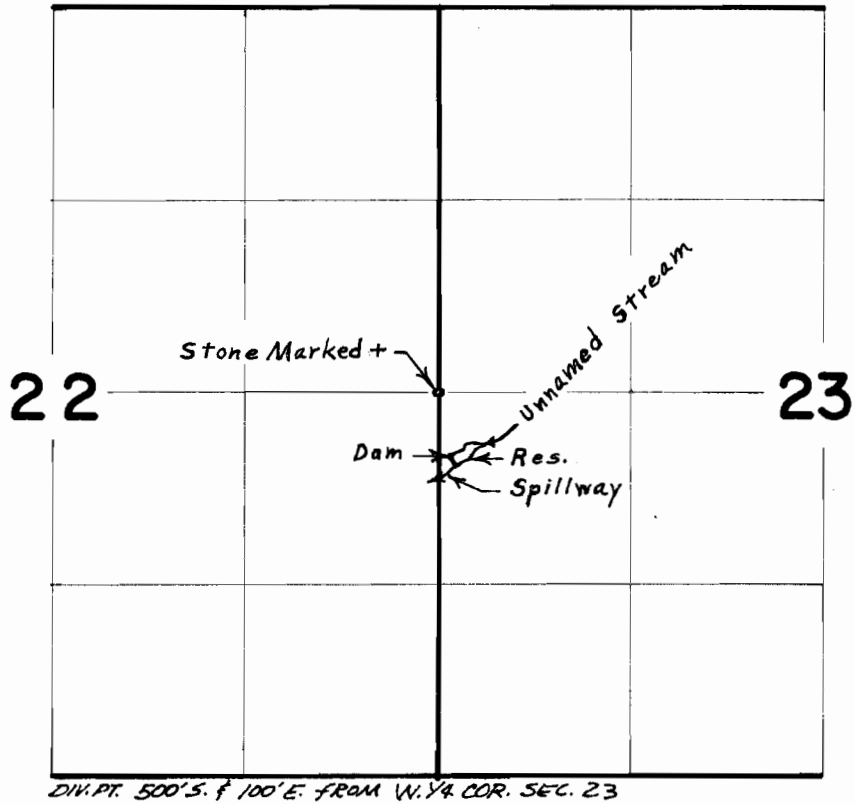

FINAL PROOF SURVEY

UNDER

Application No. ~~48476~~ ^{R-48475} Permit No. ~~36381~~ ^{R-5887}

IN NAME OF

RICHARD K. KIRBY

Surveyed May 7, 1975, by L. E. Gould