


T.28S., R. 11W., W.M.

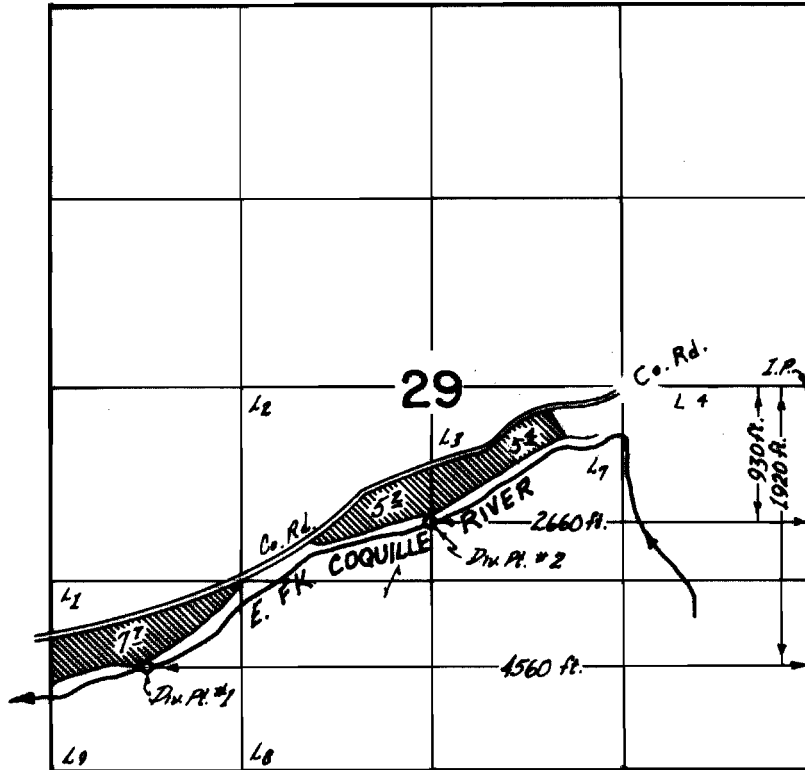

**FINAL PROOF SURVEY**  
UNDER

Application No. 40888 Permit No. 30477  
IN NAME OF

LEONARD E. PIKE

Surveyed 21 July 1972, by L. E. Gould