


T.26S.R.14W.W.M.

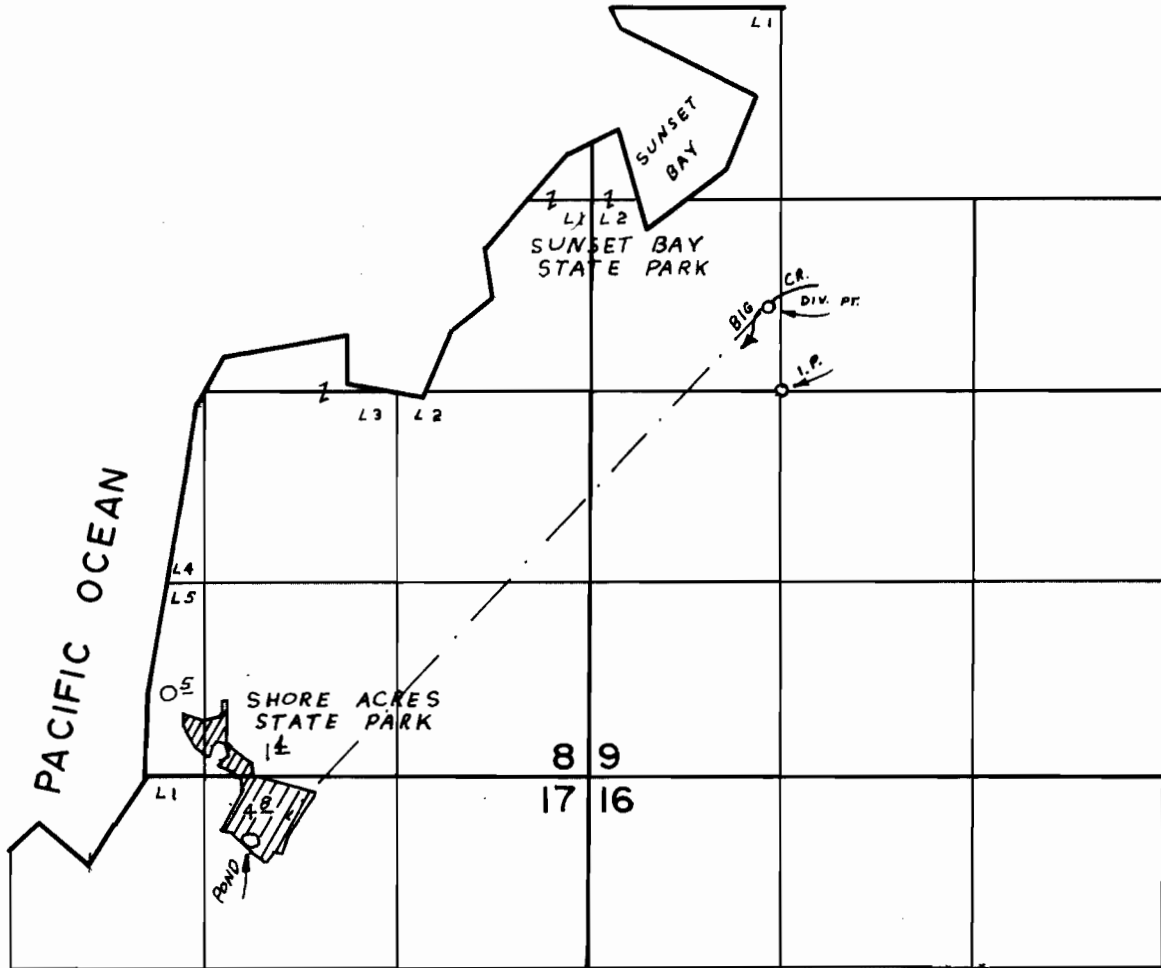

DIV. PT. LOC. 580' N. & 80' W. FROM
SE COR., SW 1/4, NW 1/4, SEC. 9

FINAL PROOF SURVEY UNDER

Application No. 43268 Permit No. 32137
IN NAME OF

OREGON STATE HIGHWAY COMMISSION

Surveyed JUL 25 1975, by L H NUNN