


T.24S. R.12W. W.M.

*May be drafted
incorrect*

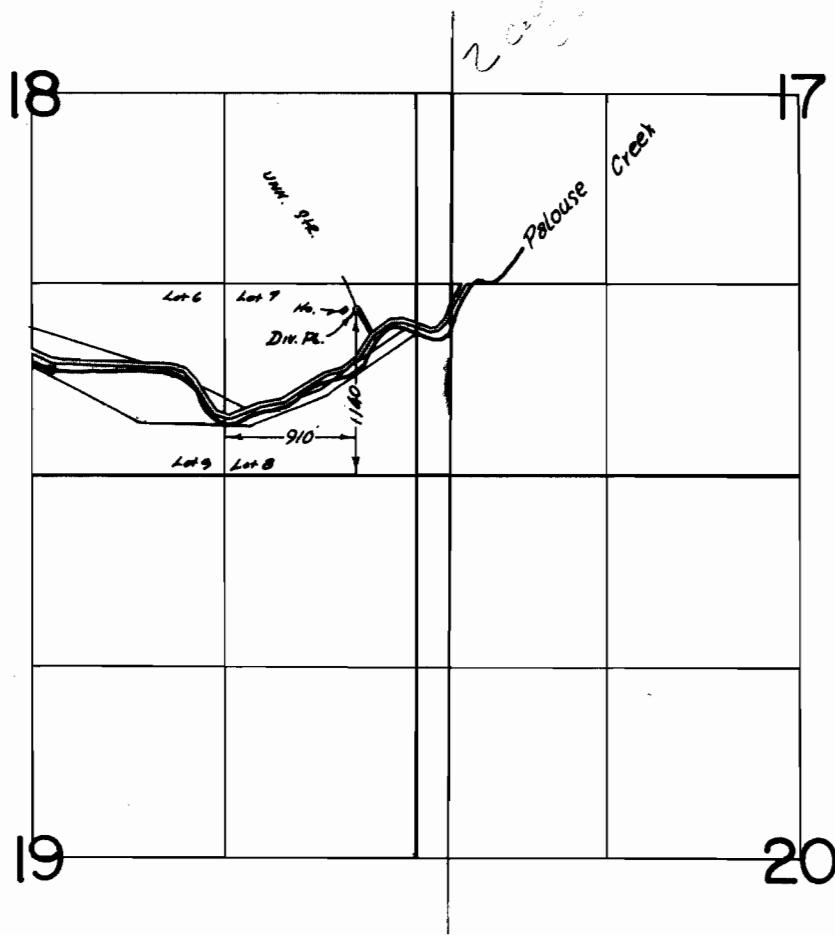

FINAL PROOF SURVEY
UNDER

Application No. 44356... Permit No. 33137....
IN NAME OF

ANTHONY G. RAGONE

Surveyed July...23 1974., by L...H...NUNN...