T.25S.R.12W.M.

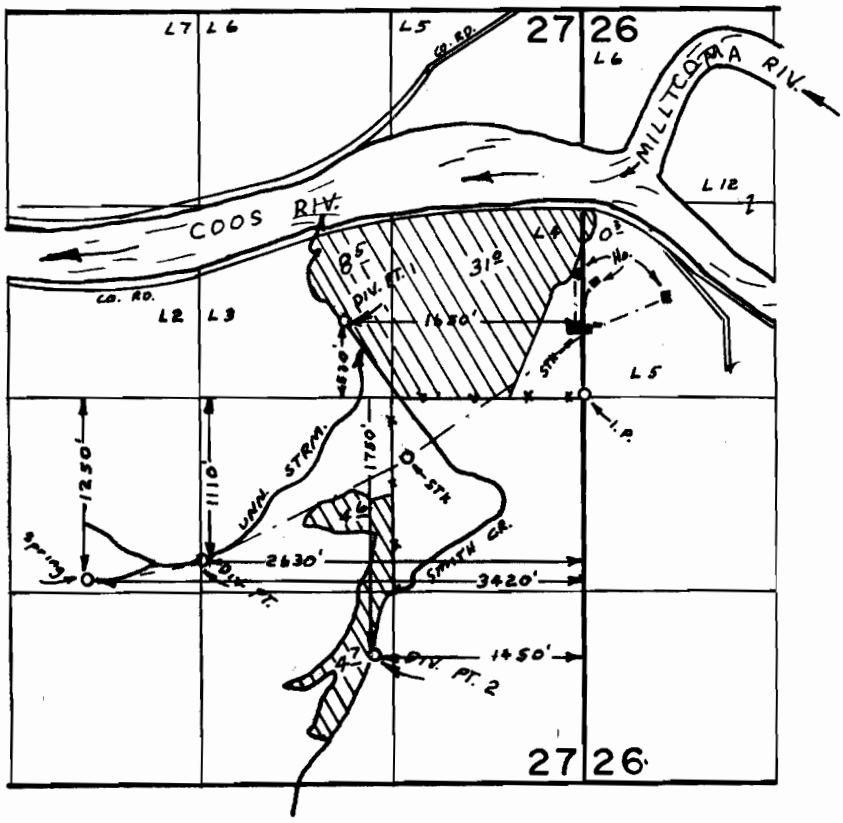

FINAL PROOF SURVEY
UNDER

45606 33989
Application No. 46610 Permit No. 34831
IN NAME OF

GEORGE W. SMITH

Surveyed AUG 1 1974, by L.H. NUNN

COB-2HH-35 & 123 LHN