


# T.25S.R.12W.M.

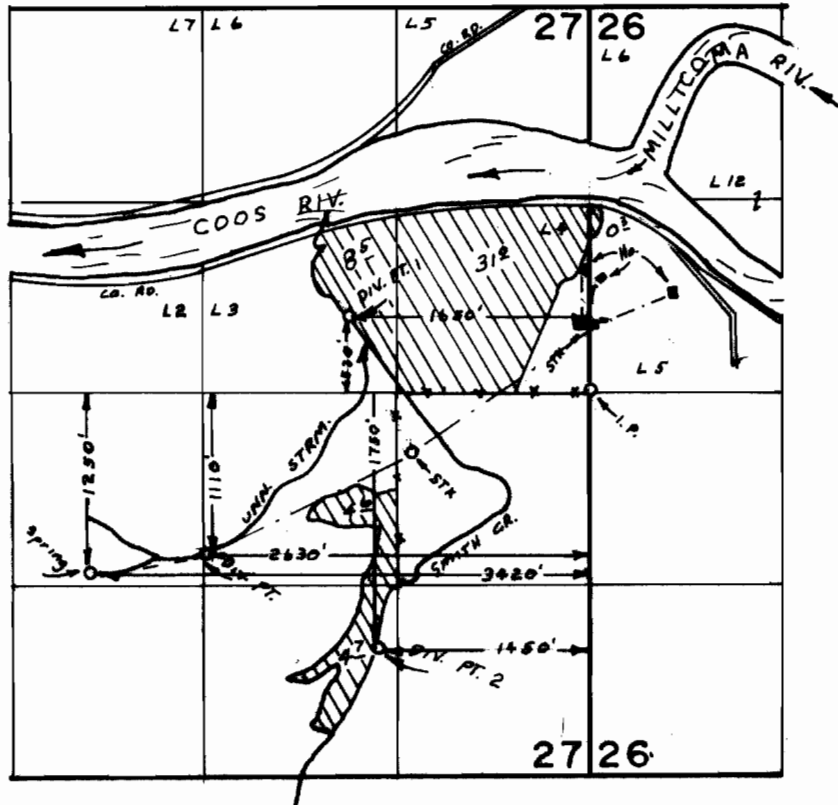

## FINAL PROOF SURVEY UNDER

45606                      33989  
Application No. 46610 Permit No. 34831  
IN NAME OF

GEORGE W. SMITH

Surveyed AUG. 1 1974, by L.H. NUNN