


T.26S.R.12W.M.

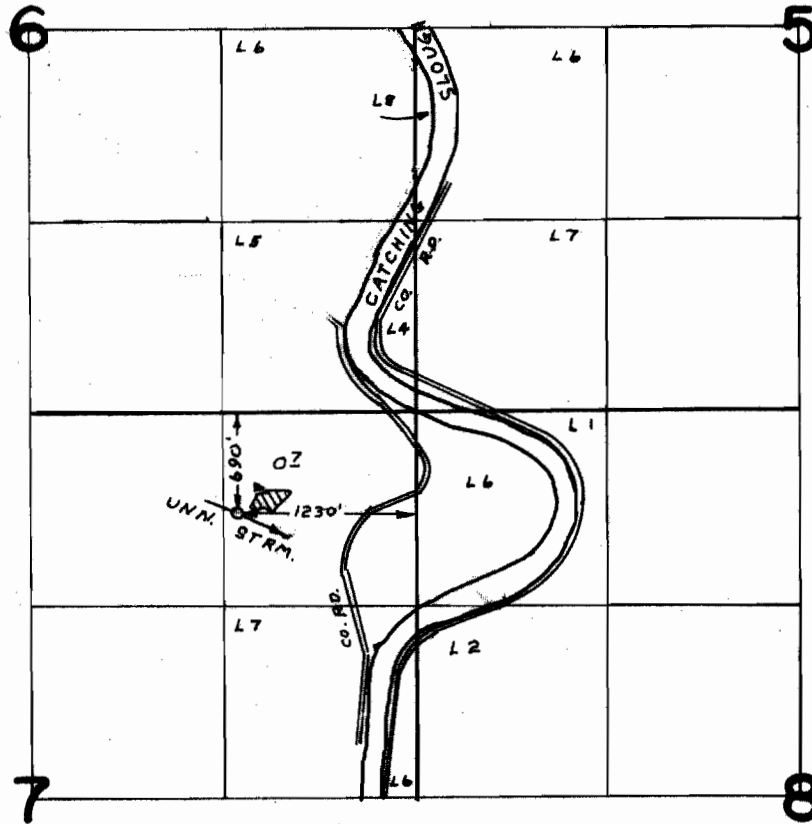

**FINAL PROOF SURVEY**  
UNDER

Application No. 48032 Permit No. 35338  
IN NAME OF

DARRELL L. ORR

Surveyed JUL 31 1974, by LH NUNN