


T.22S., R.12W., W.M.

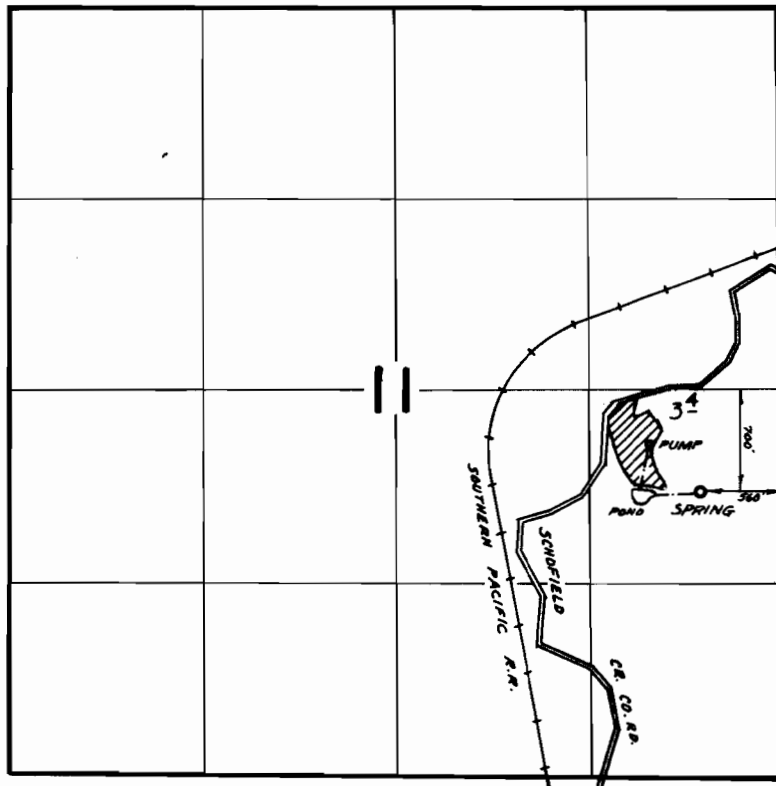

FINAL PROOF SURVEY
UNDER

Application No. 44316 Permit No. 33294
IN NAME OF

CHARLES A. PFEIFFER

Surveyed July 21 1975, by D. Norby