


T.23S., R.10W., W.M.

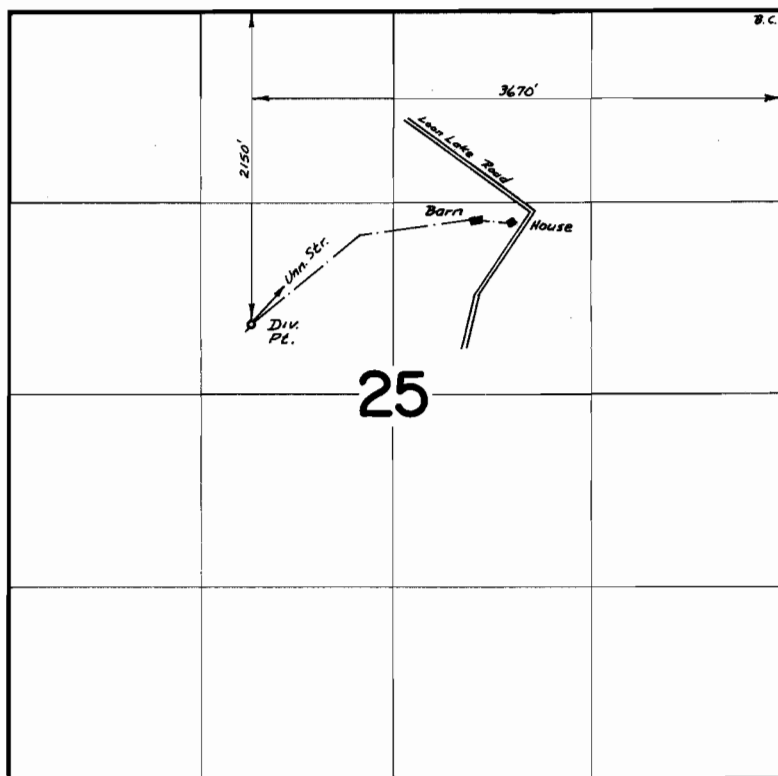

FINAL PROOF SURVEY
UNDER

Application No. 44617 Permit No. 33499
IN NAME OF

JOHN MUENCHRATH

Surveyed July 23 1975, by D. Norby