


# T.26S. R.4W. W.M.

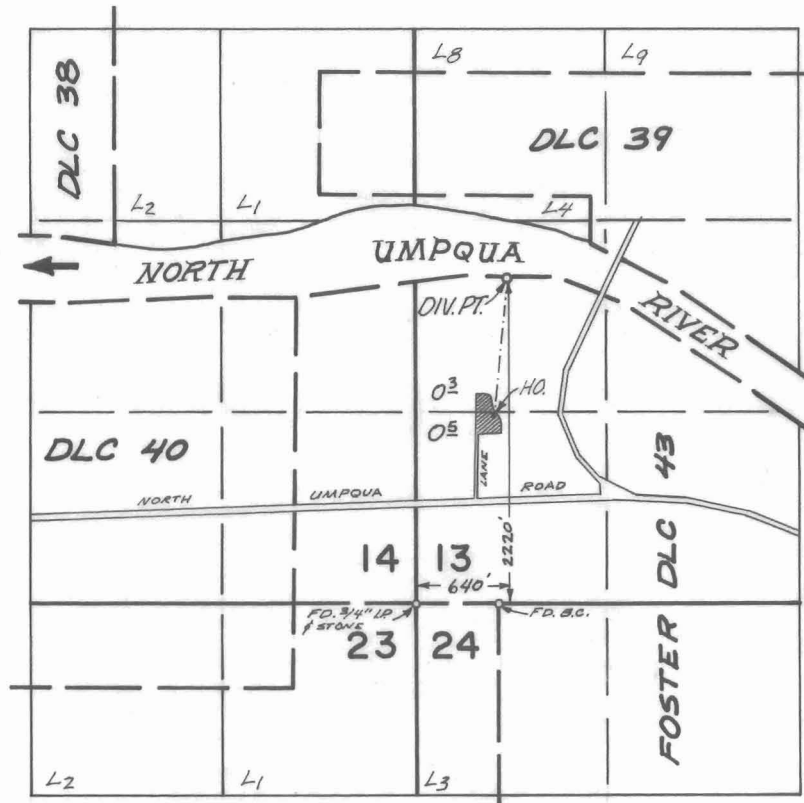

## FINAL PROOF SURVEY UNDER

Application No. 46144 Permit No. 34475  
IN NAME OF

ROLLYN L. GLASSFORD

Surveyed JUNE 19 1974, by L.M. TOLL