


T.27S., R.6W., W.M.

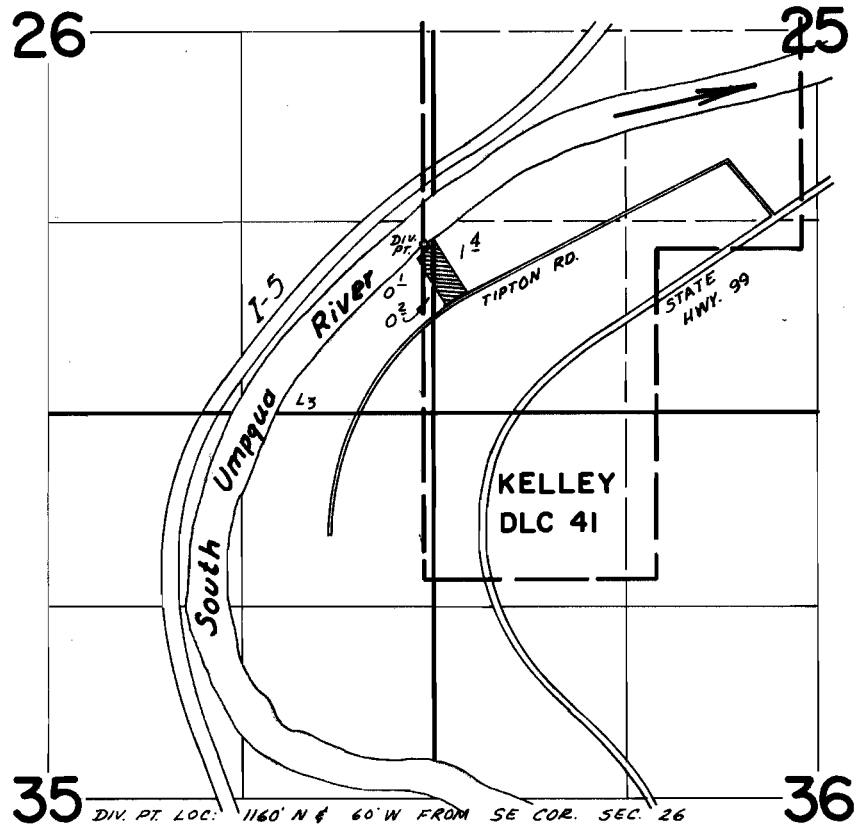

**FINAL PROOF SURVEY**  
UNDER

Application No. 48193 Permit No. 36200  
IN NAME OF

JAMES W. KEETON

Surveyed Nov. 6 1975, by D. Norby