


T. 29 S. R. 4 W. W.M.

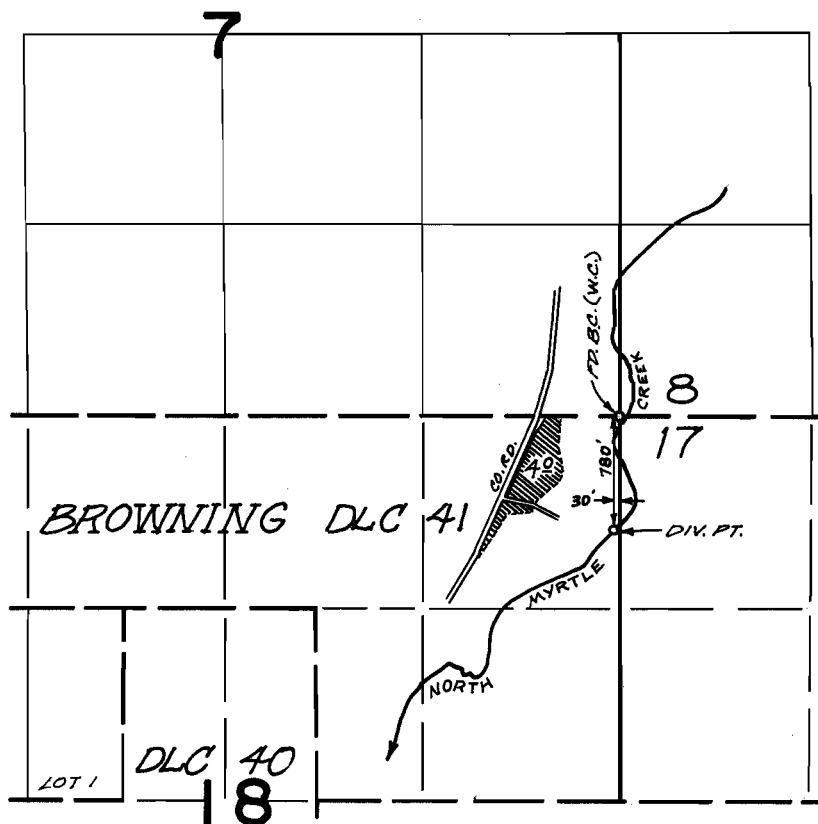

FINAL PROOF SURVEY
UNDER

Application No. 48524 Permit No. 36407
IN NAME OF

JAMES W. CLACK

Surveyed JUNE 19 1974, by D. NORBY