


T.26S. R.3W. W.M.

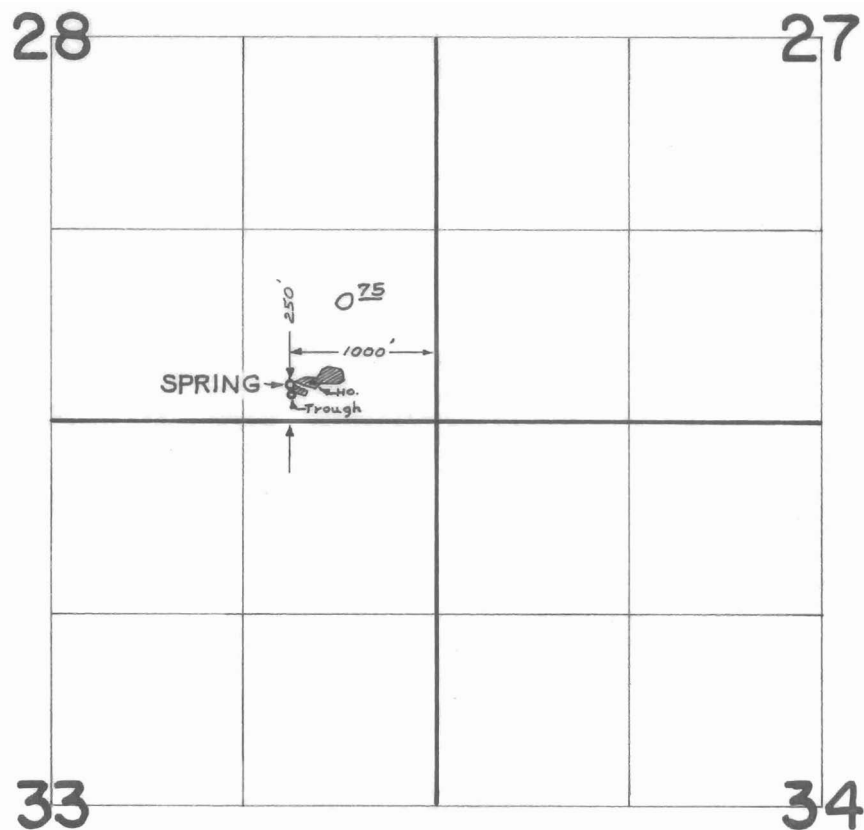

FINAL PROOF SURVEY
UNDER

Application No. 49578 Permit No. 36784
IN NAME OF

J. C. LIVINGSTON

Surveyed SEPT. 16, 1975, by R. MUCKEN