


T.26S. R.2W. W.M.

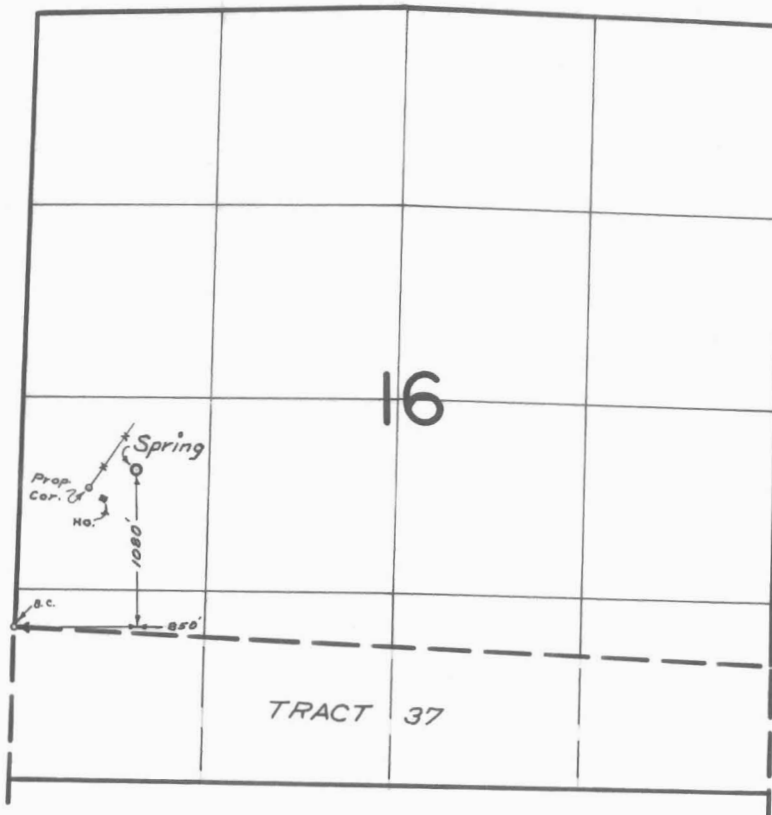

FINAL PROOF SURVEY
UNDER

Application No. 49496 Permit No. 37067
IN NAME OF

HAROLD P. SHEARS

Surveyed SEPT. 17, 1975, by R. MUCKEN