


T.21&22S.,R.5W.,W.M.

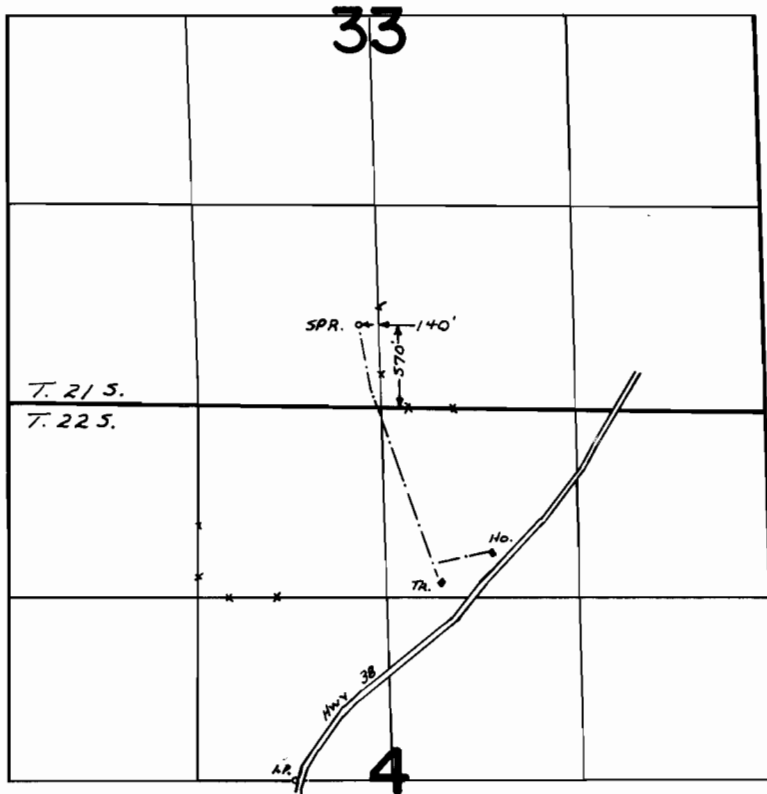

**FINAL PROOF SURVEY**  
UNDER

Application No. 52335 Permit No. 37532  
IN NAME OF

EARL E. & MARGARET M. HARRIS

Surveyed JUNE 3, 1975, by L. E. Gove