


T.36 S., R.7 W., W.M.

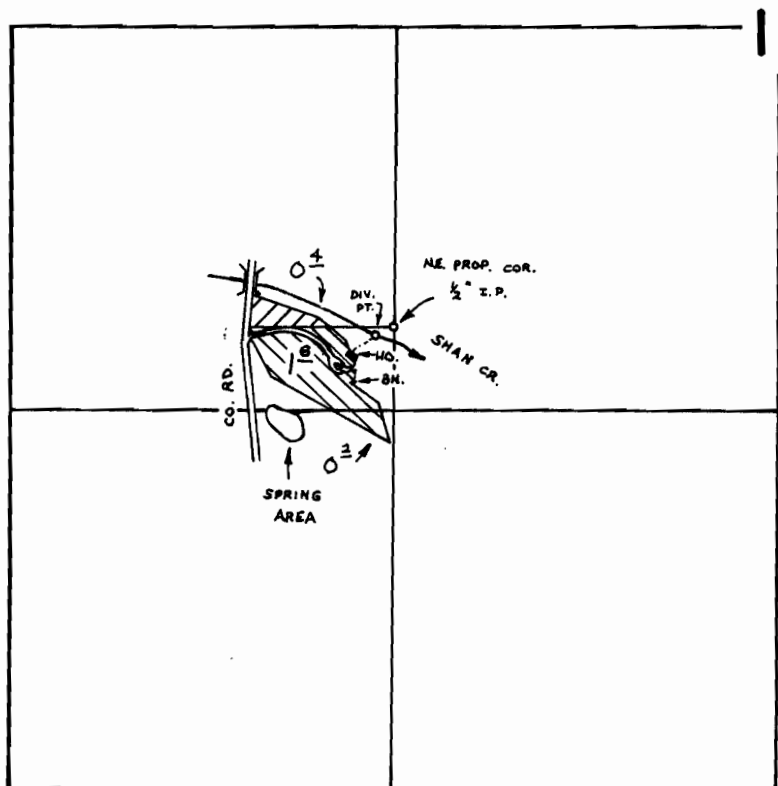

DIV. PT. LOC.: 1060'S. & 1250'E., SPRING LOC. - 1350'S. & 950'E.,  
BOTH FROM W. 1/4 COR., SEC. 11.

SCALE: 1" = 660 FT.

## FINAL PROOF SURVEY

UNDER

51002 38496

50119 37661

Application No. 50704 Permit No. 38297

IN NAME OF

DANIEL LARRY JACKSON

Surveyed NOV. 14 1977, by B. SUND



D.H.M.

P.T.S. - 1977 - 14 - B